


SECTION 10, T 30, R 22 (N 1/2)

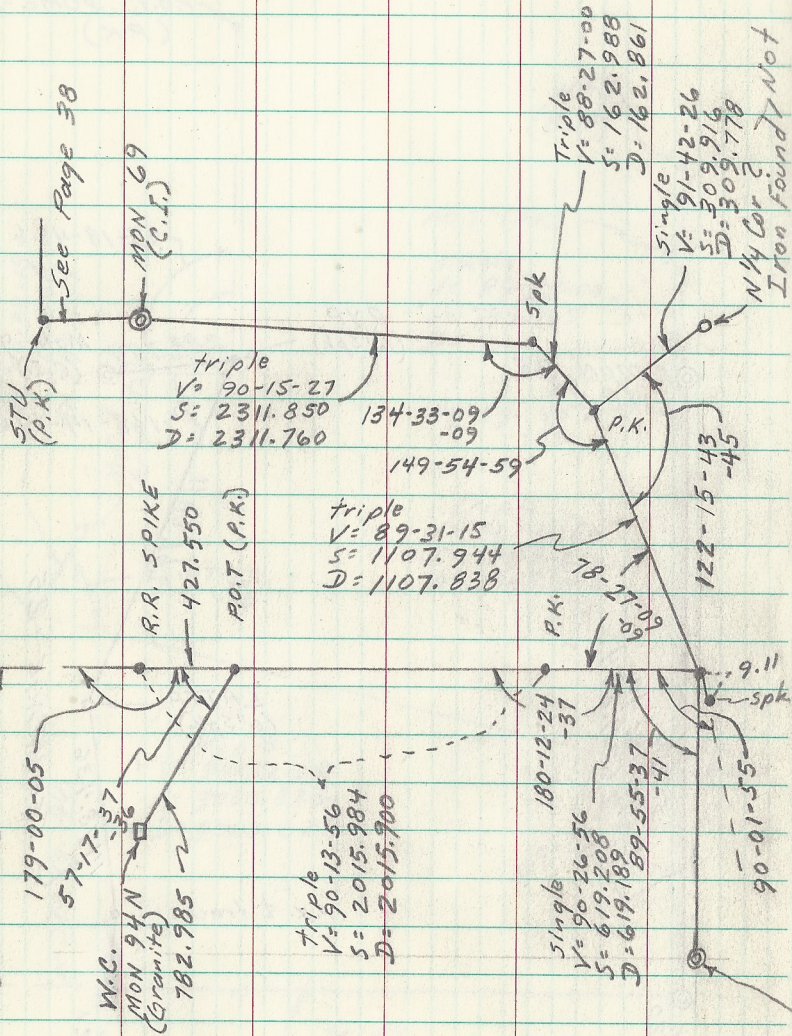

274.9
498.70
279.716

33

