


SECTION 4, T30, R22 (N½)

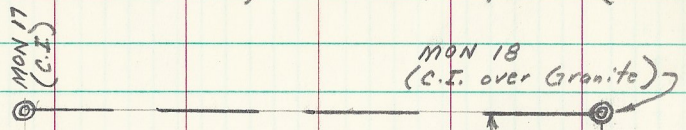

See SURVEY Book I, Pg. 10, 11

