SECTION 4, T30, R22 (5½)

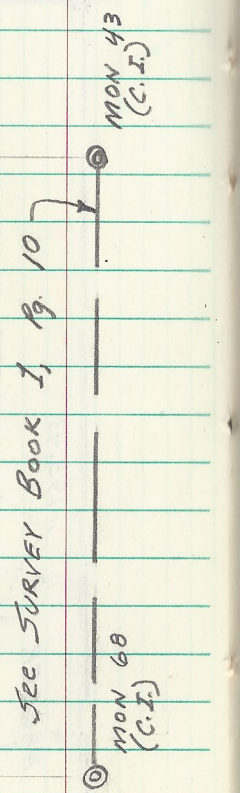

R.M.
L.P.D.
D.S.
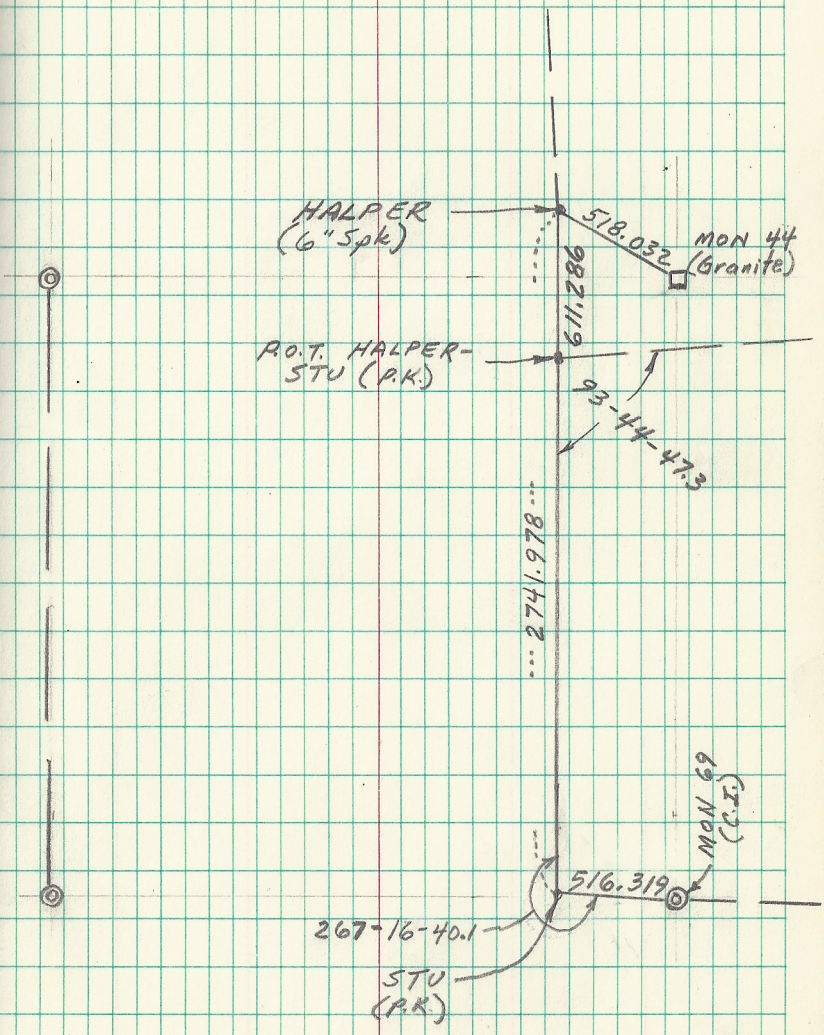
MAY, 1984 E. line SE¼