


SECTION 27, T30, R22 (Continuing)

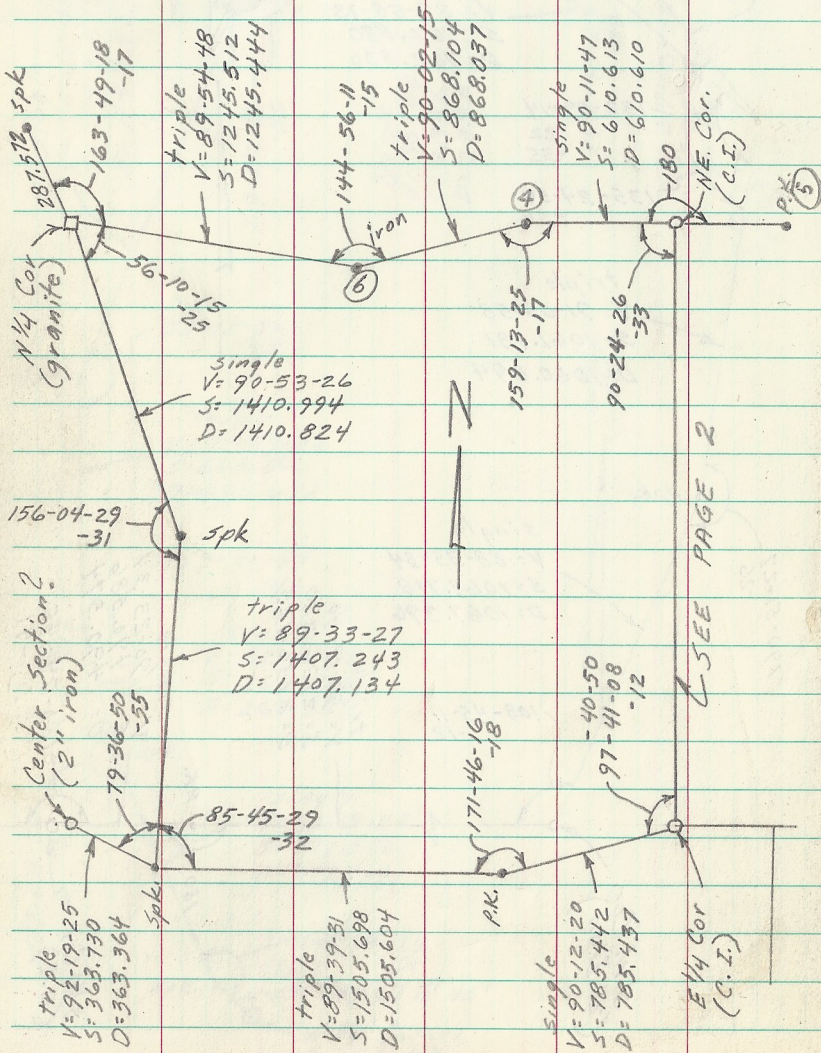

TIES ON PAGE 15

