


SECTION 29, T30, R22 (Continued)



TIES

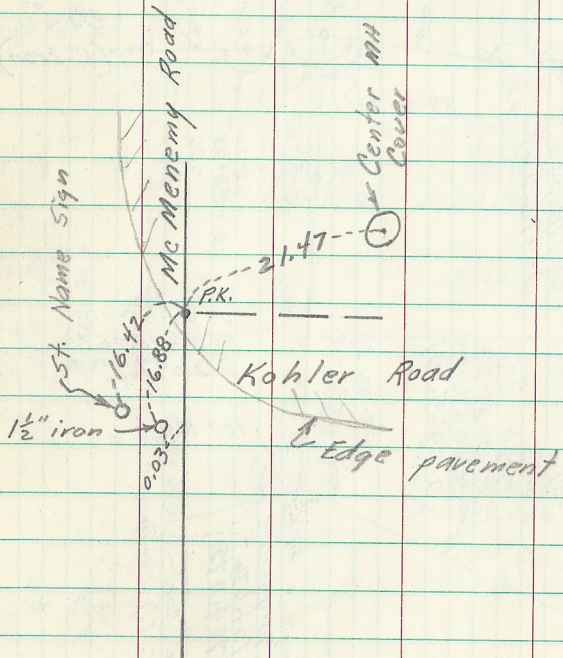