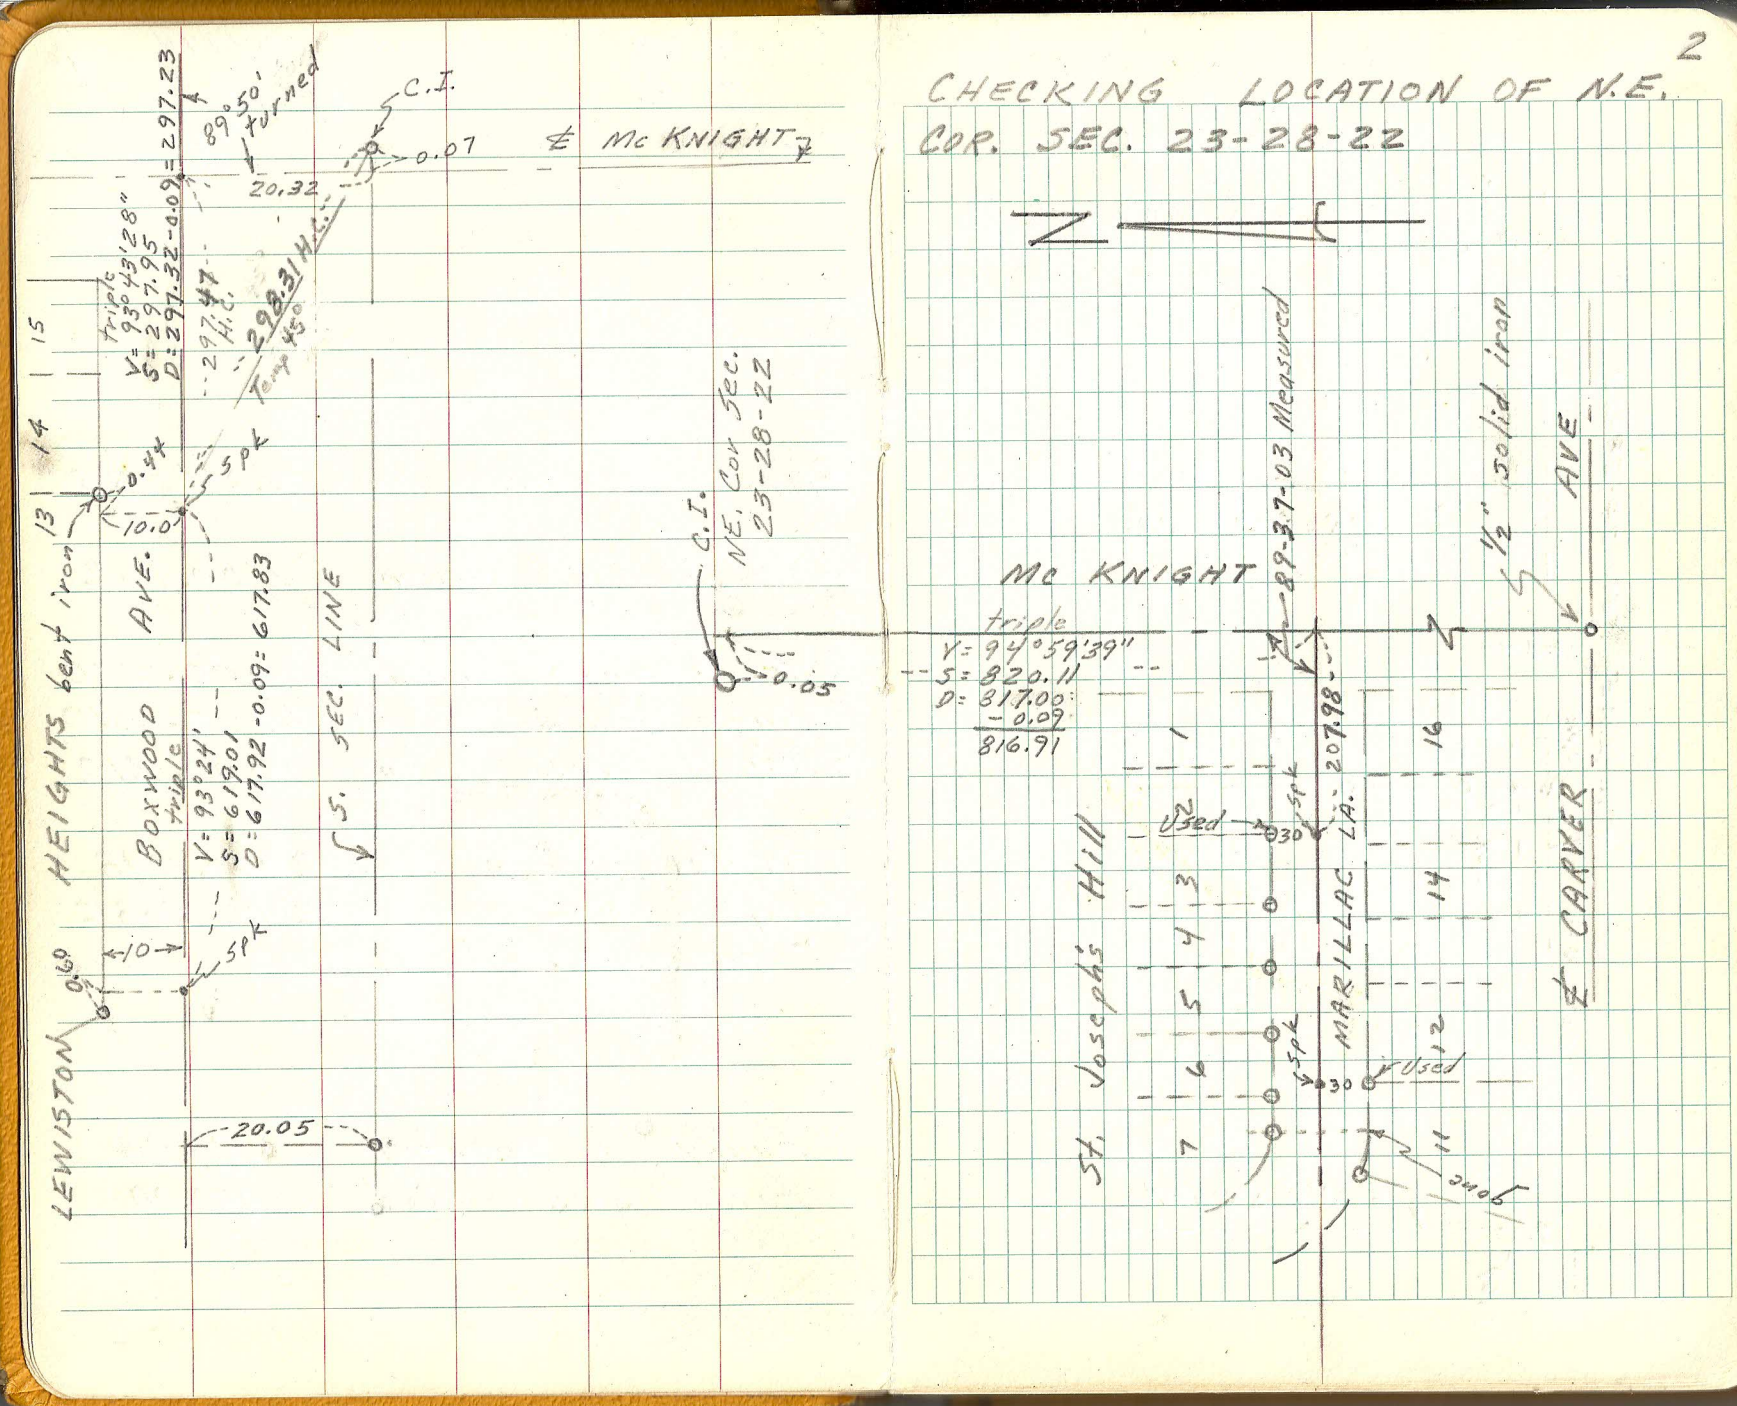
CHECKING LOCATION OF N.E. COR. SEC. 23-28-22
N
℄ Mc KNIGHT
C.I.
NE. Cor Sec. 23-28-22
Mc KNIGHT
triple
V= 94°59'39"
S= 820.11
D= 817.00
-0.09
816.91
89°37'03" Measured
½" solid iron
AVE
℄ CARVER
St. Joseph's Hill
MARILLAC LA.
Used
Used
30
30
20.05
20.32
89°50' turned
0.07
0.05
0.44
0.60
10.0
10
Spk
Spk
Spk
Spk
triple
V= 93°43'28"
S= 297.95
D= 297.32
-0.09
=297.23
297.47
Hi.
298.31 Hi.
Temp 45°
Boxwood
triple
V= 93°24'
S= 619.01
D= 617.92
-0.09
= 617.83
S. SEC. LINE
LEWISTON HEIGHTS
bent iron
AVE.
13
14
15
1
2
3
4
5
6
7
11
12
14
16
and 6