


RELOCATING CENTER SEC. 15-29-23

AUG. 16-22, 1974

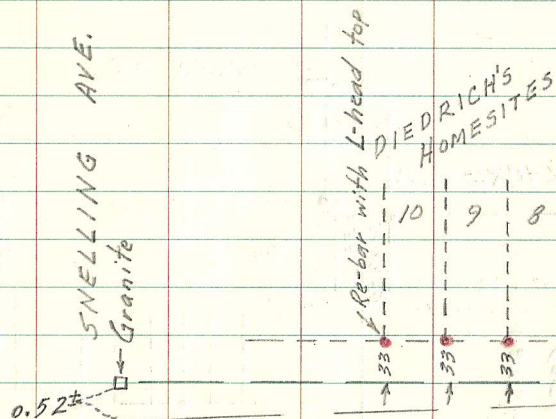

REPLACED IRON WITH C.I.
AND MOVED IT 0.24' NORTH
AND 0.10' EAST

