Survey For Open Space Of Two Parcels In NE¼ Sec. 6-30-22

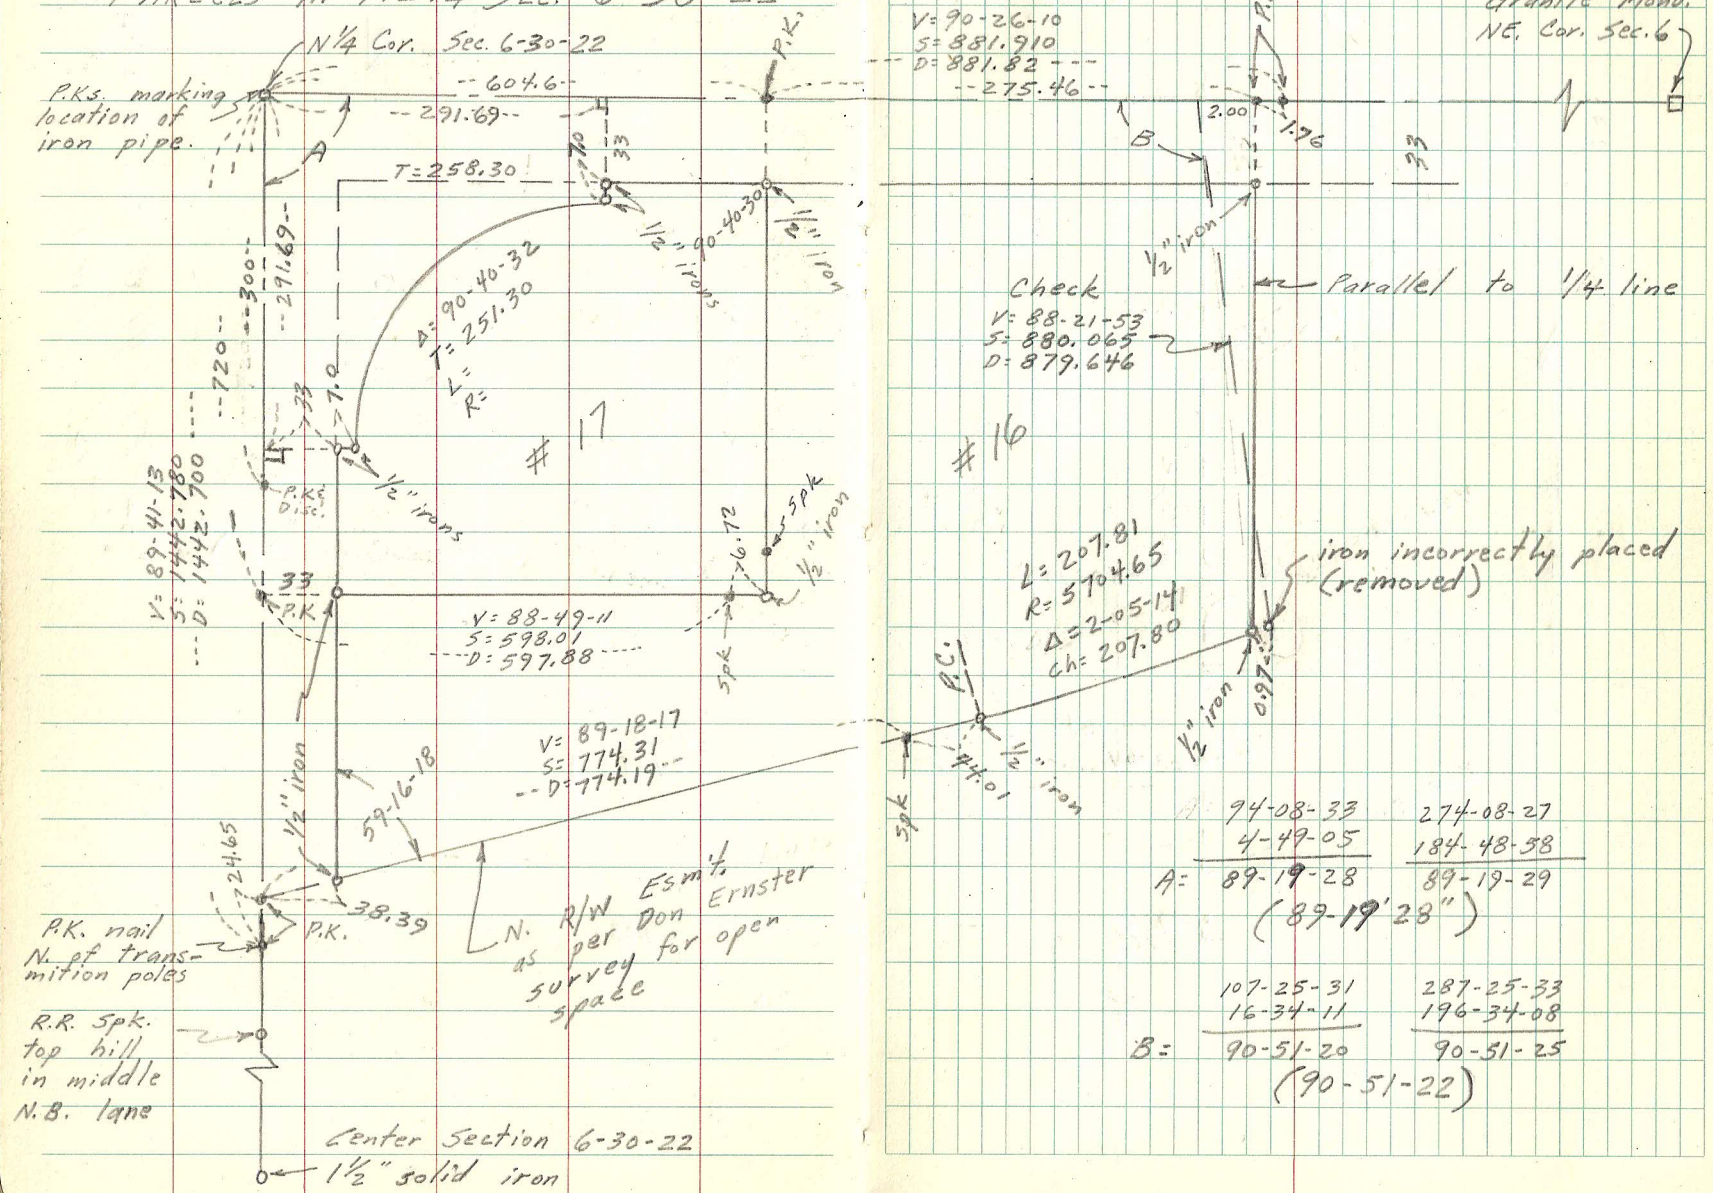

	94-08-33	274-08-27
	4-49-05	184-48-38
A=	89-19-28	89-19-29
	(89-19'28")	

	107-25-31	287-25-33
	16-34-11	196-34-08
B=	90-51-20	90-51-25
	(90-51-22)	