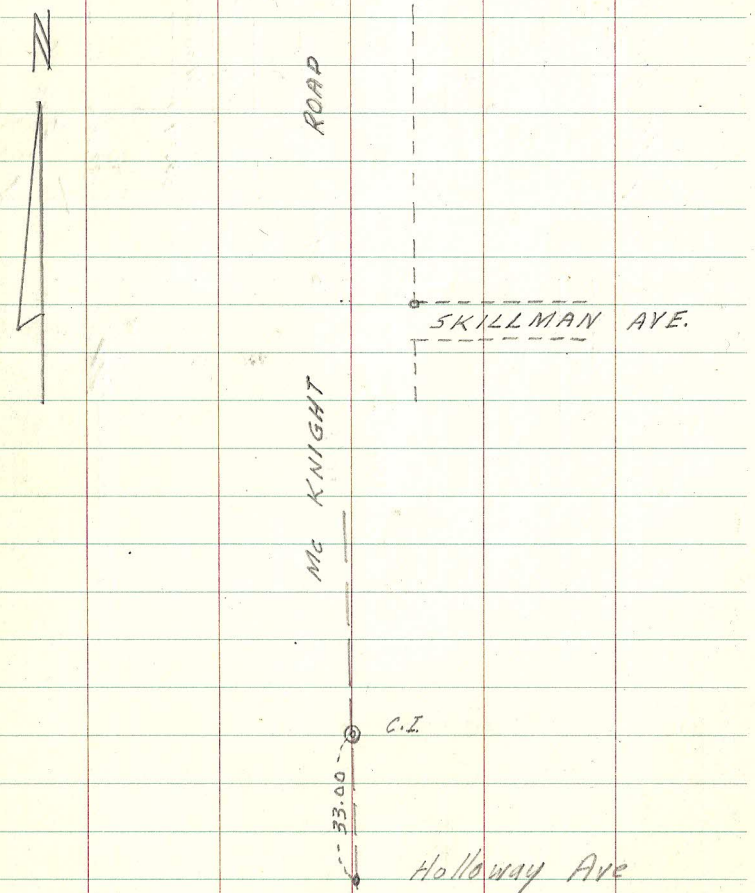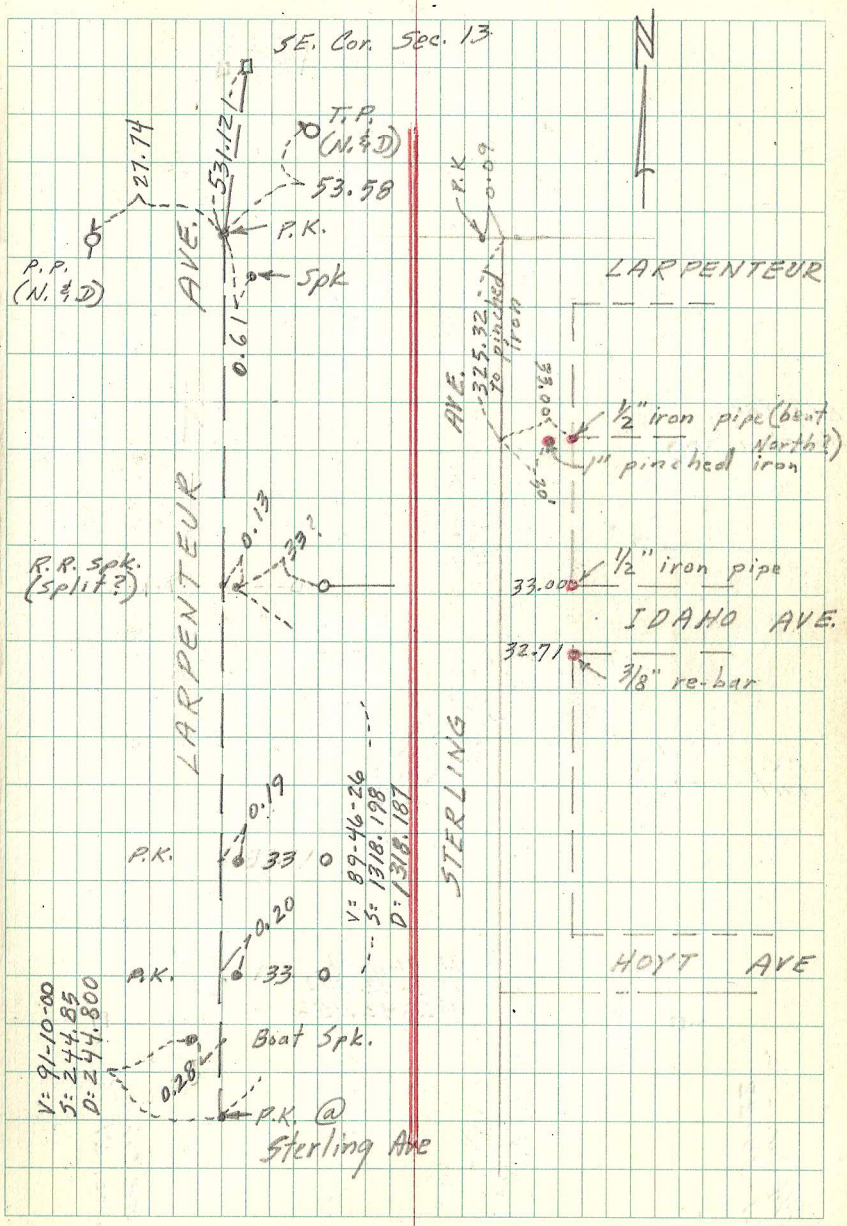SECTION 13, T29, R22