SECTION 24, T29, R22
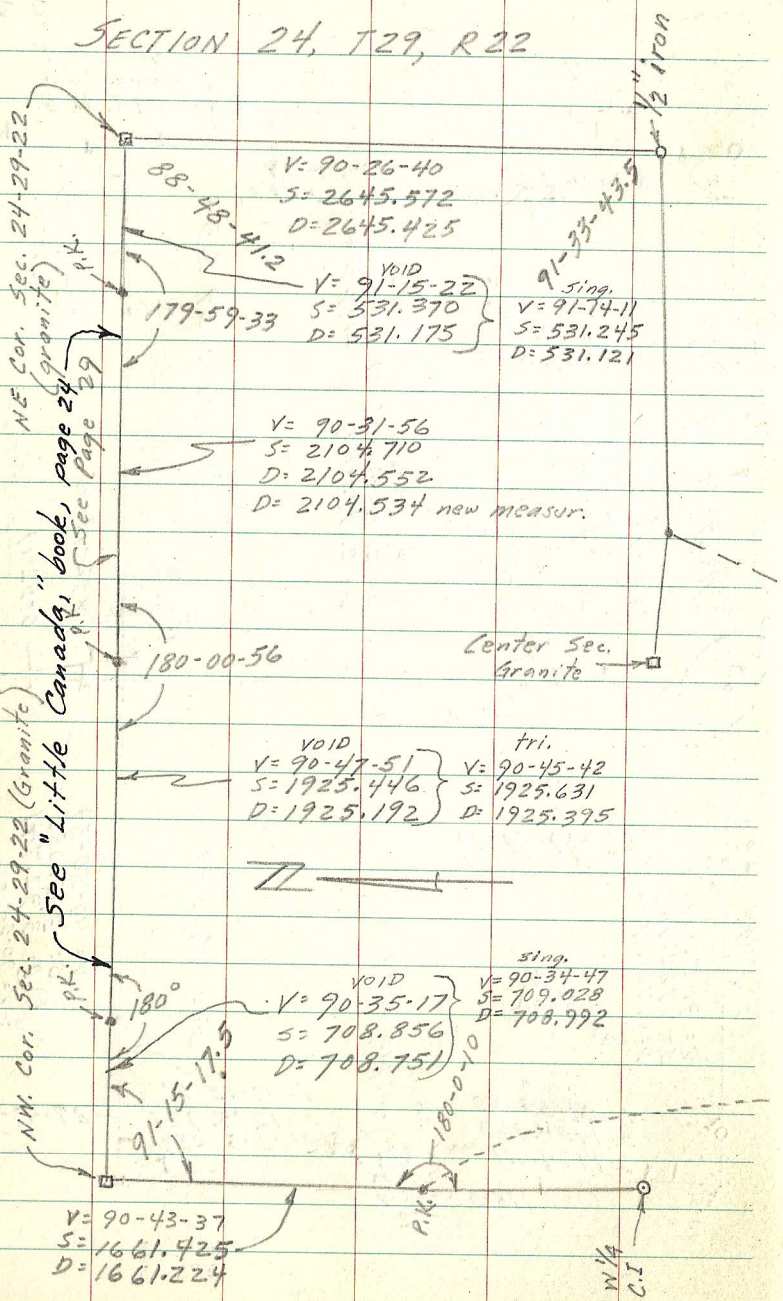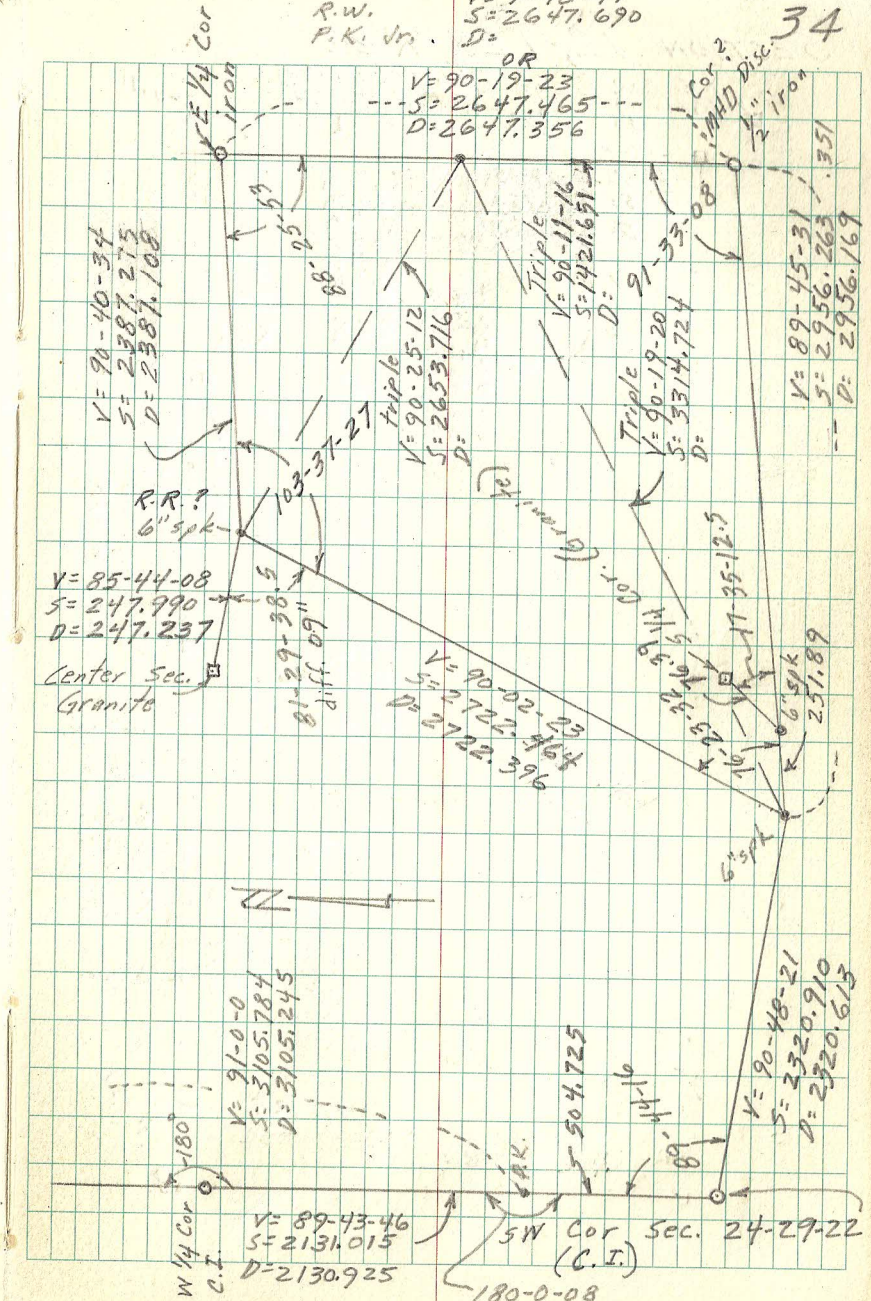
Nov. 1974 R.F.M. R.W. P.K. Jr.