



SECTION 12, T28, R22 (Checking  
E 1/4 Corner)

CENTURY

AVE.

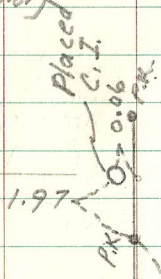


1/6 Cor. (Stone)

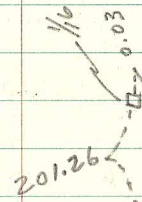

triple  
 $V = 90.36-18$   
 $S = 1517.456$   
 $D = 1517.304$

single  
 $V = 90.58-57$   
 $S = 1116.860$   
 $D = 1116.696$

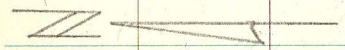

Center Section  
12-28-22

