
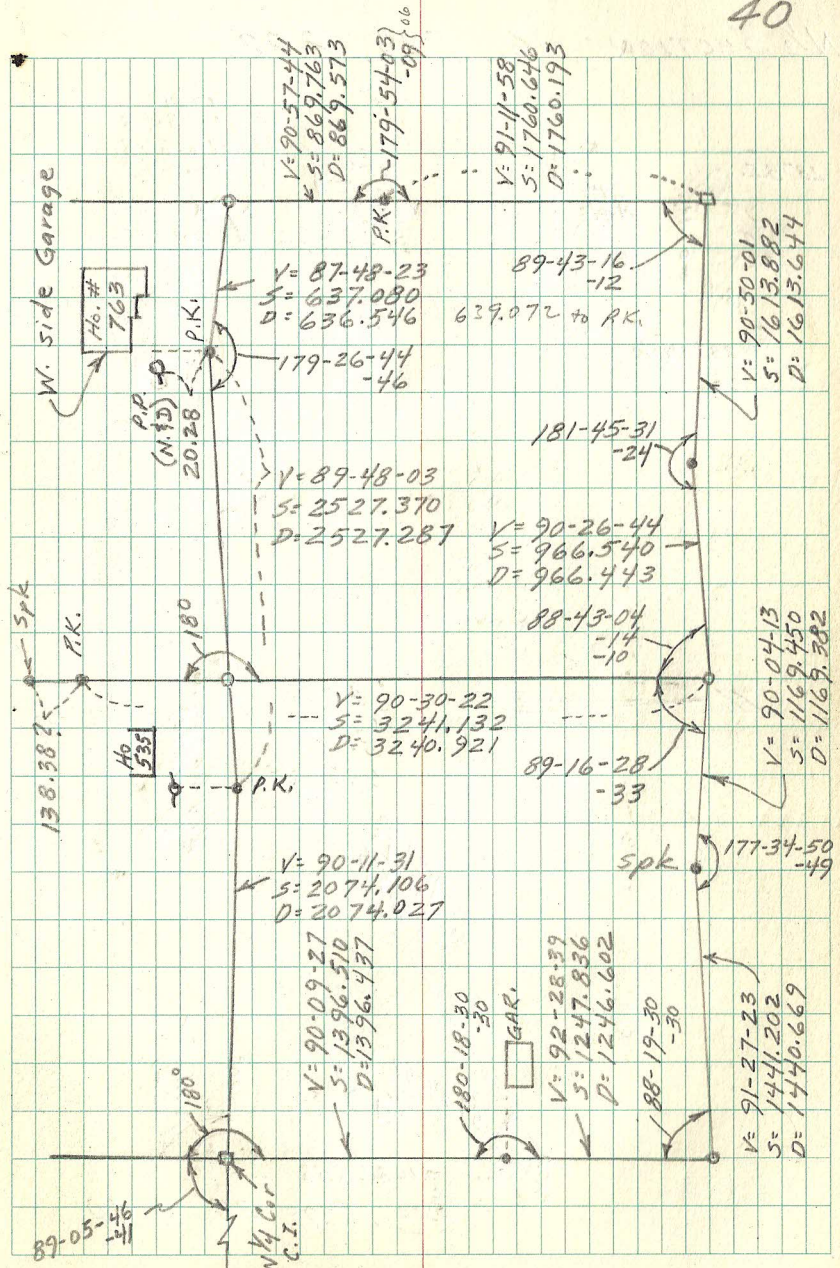


SECTION 17, T29, R22.

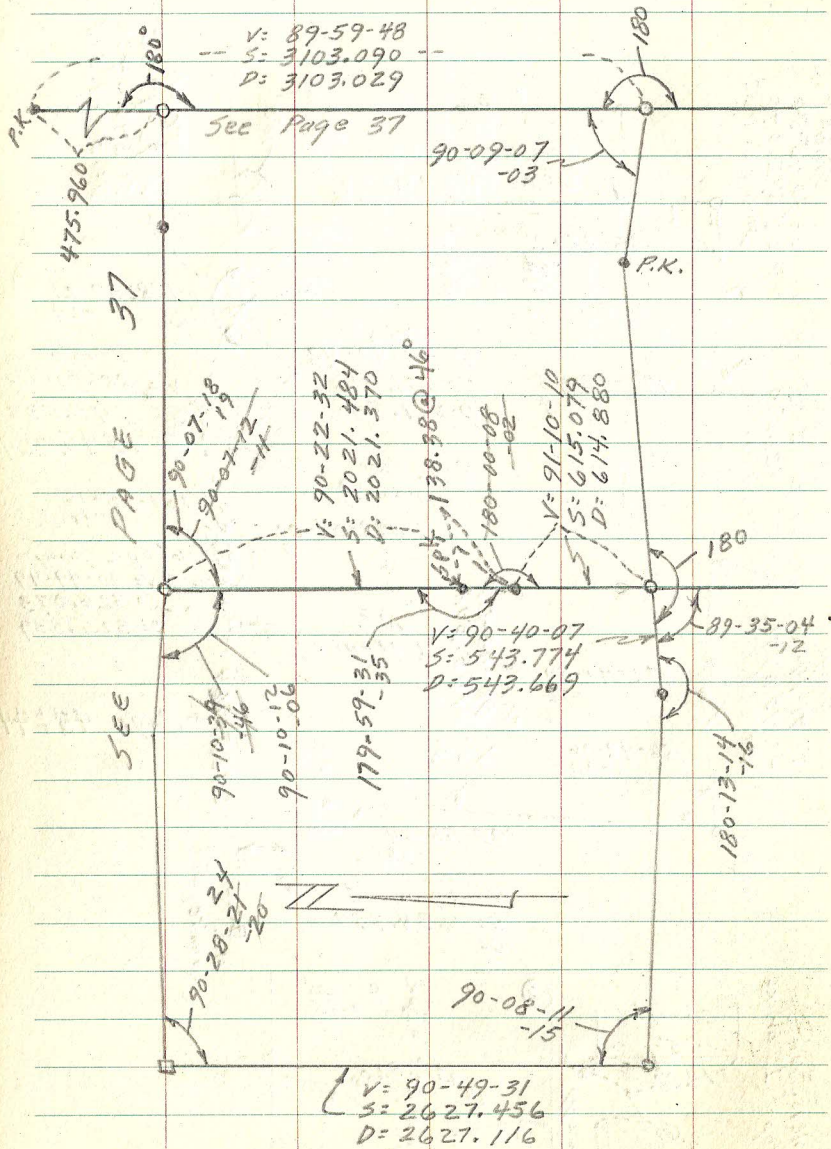

Center Sec. 18-29-22 (C.I.)