


(See "Little Canada & Mc Lean," pg. 5)

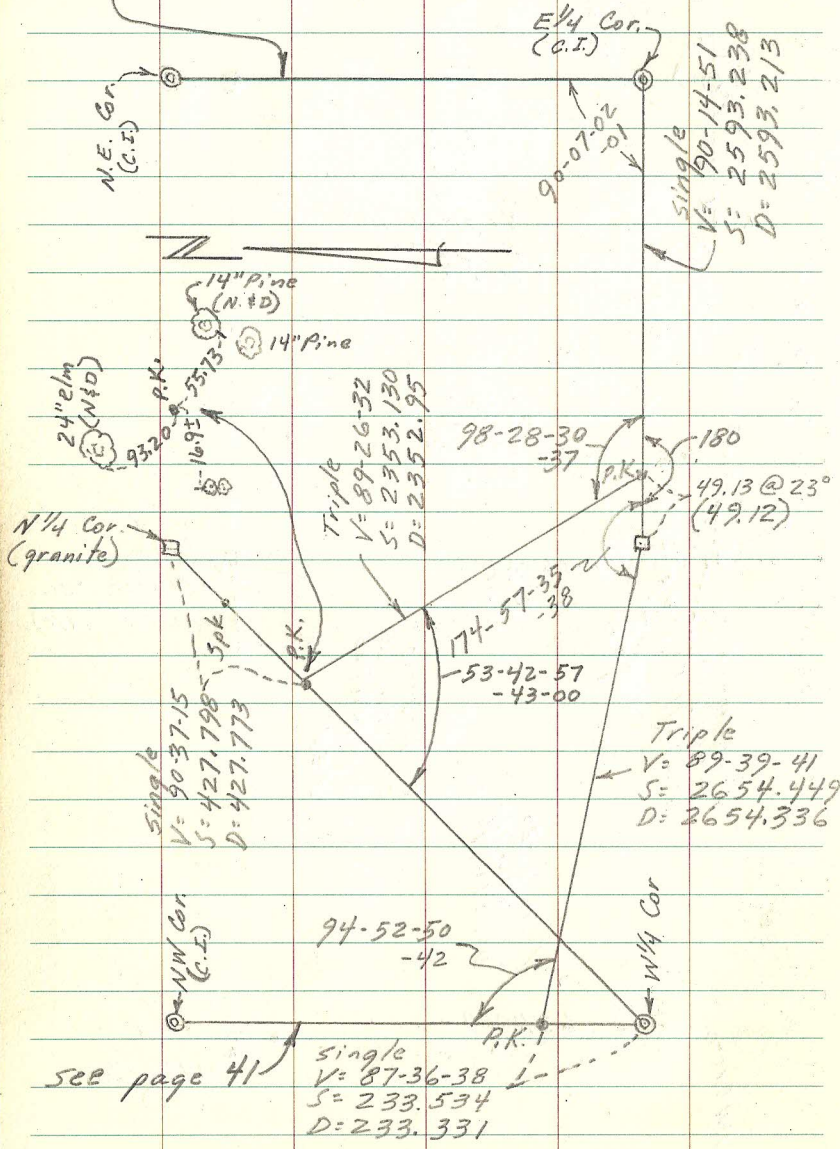

(See "Little Canada & Mc Lean," pg. 5)

