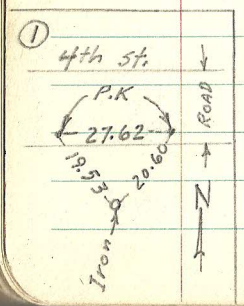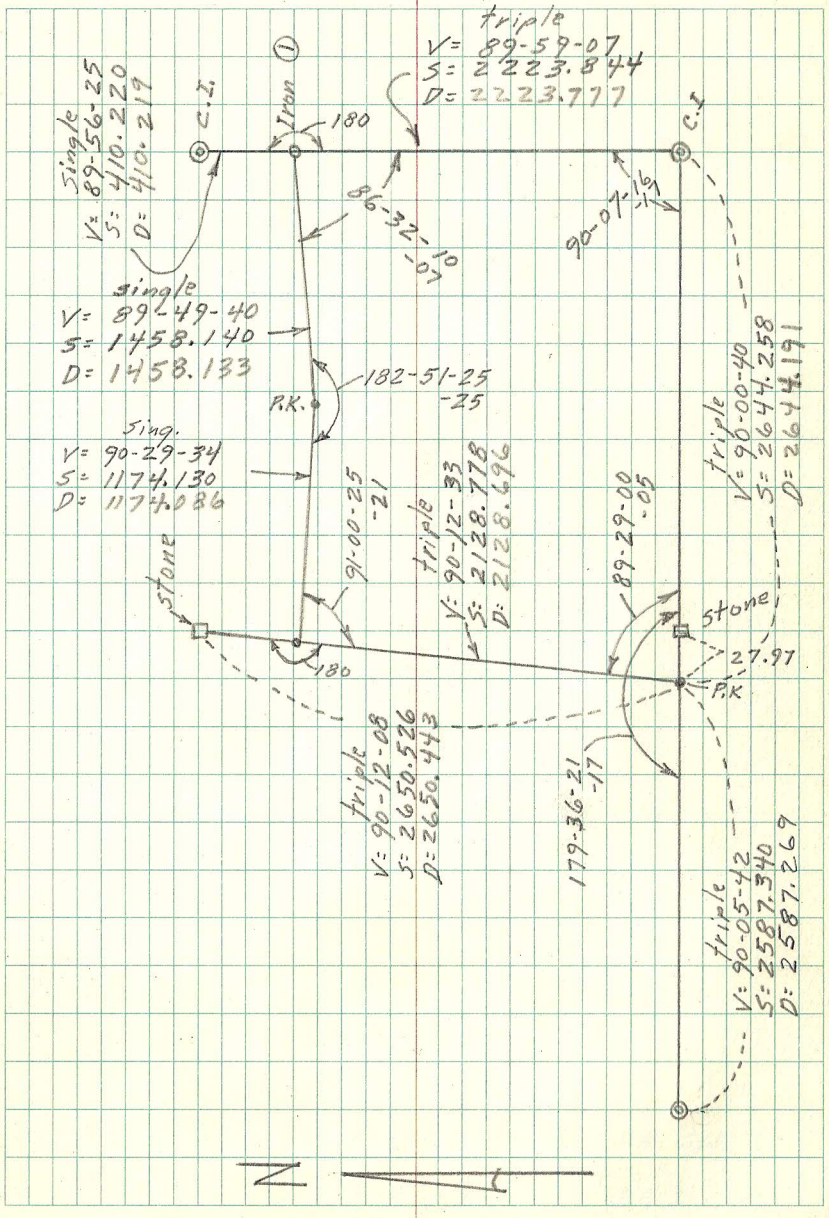Section 15, T 30, R 22.