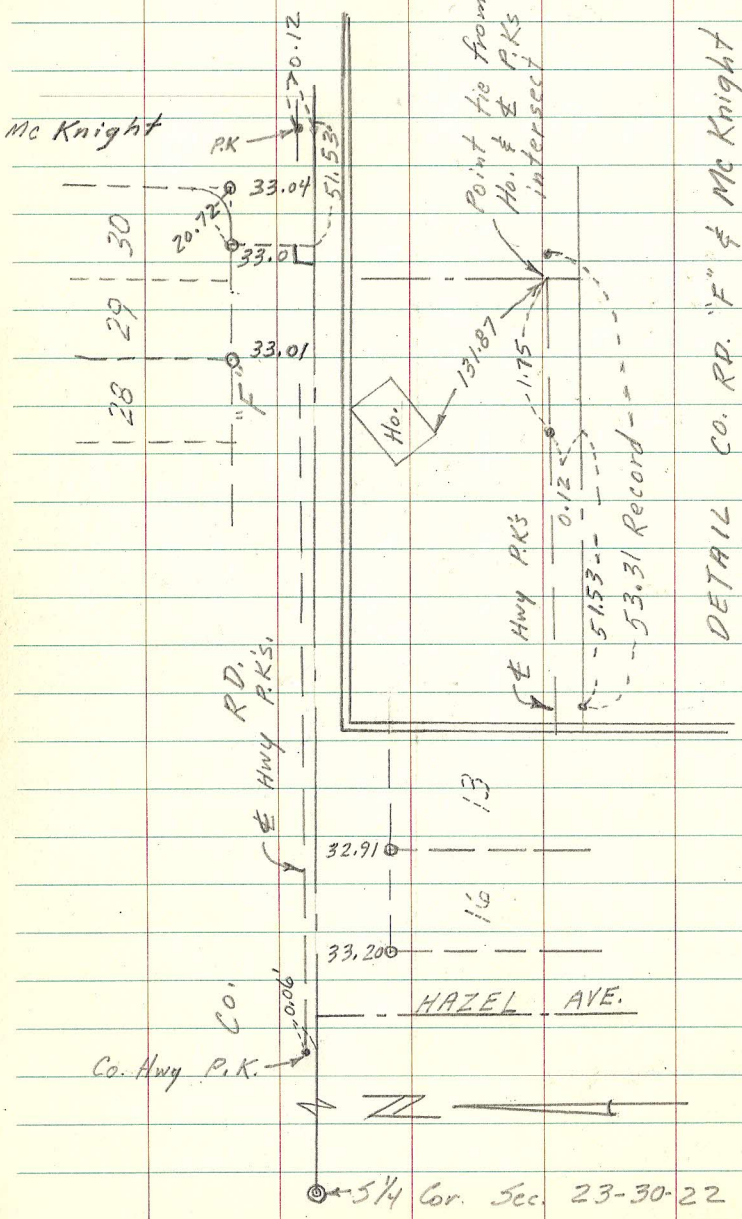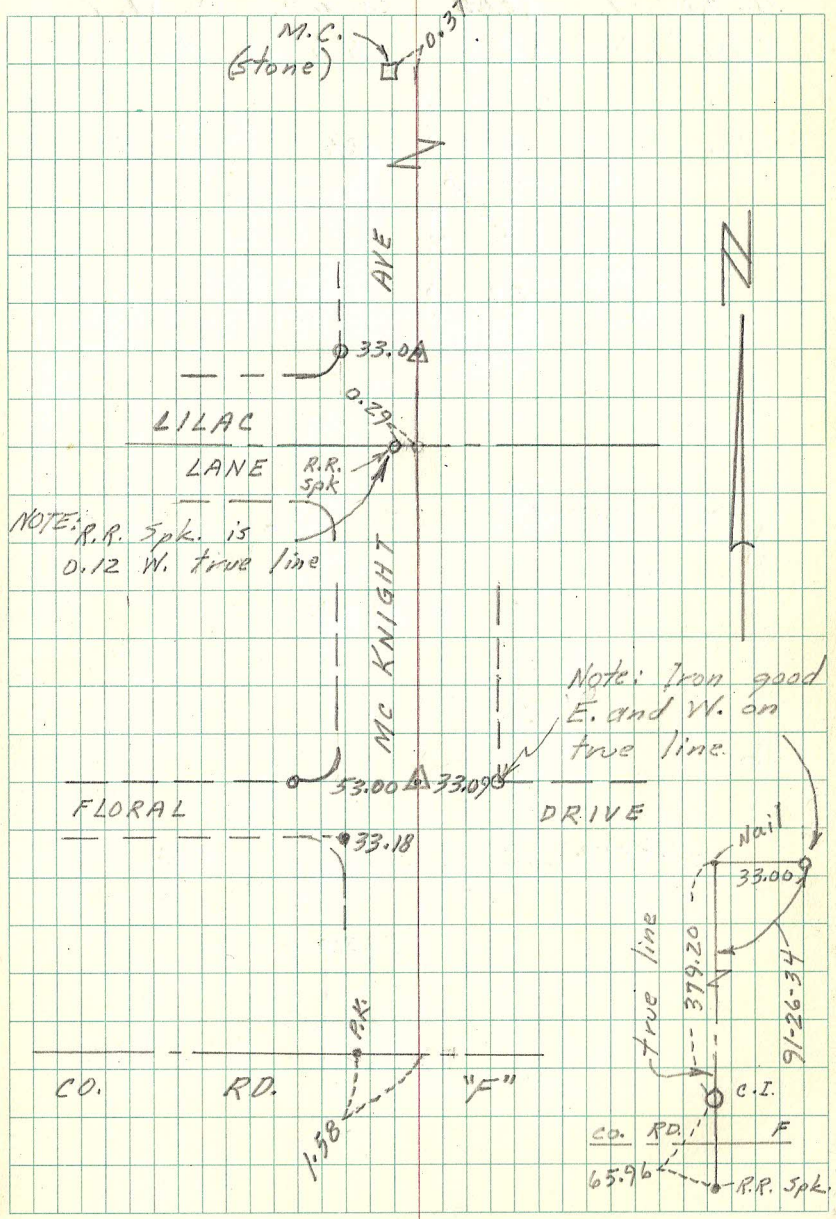South & East Line SE¼ Sec. 23, T30, R22.