

SECTION 26, T30, R22.

N 1/4 Cor. Sec. 26-30-22  
2.00




Center Section  
drill hole @ Cedar Ave.  
2.00

5/4 Cor.  
1.95

55

E 1/4 Cor. Sec. 26-30-22  
(C.T.)

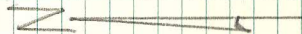

#2195  
P.K.

Center Section  
drill hole @ Cedar A.  
& W. B. Ave.

#1893  
P.K.

W 1/4 Cor.  
Sec. 26  
(R. R. spk) 39.55

Point of original  
bolder (placed  
1/2" I.D. iron on  
Aug. 25, 1975)

Ties to R.R.  
Spk. are good  
as per Co. Hwy.  
notes.

P.K.  
0.06  
49.64