


SEC. 13-28-22

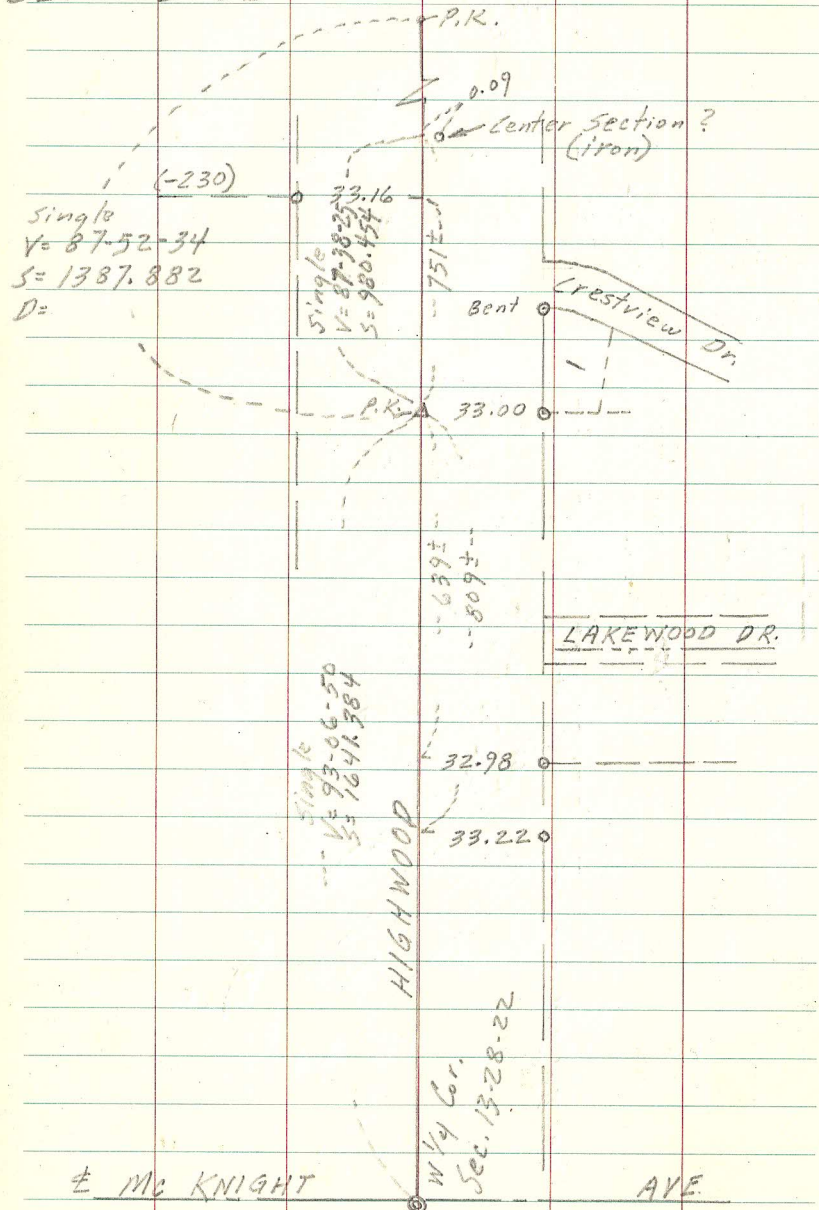

E. 1/4 Cor. Sec. 13-28-22

