


SECTION 5, T30, R23 (W<sup>1</sup>/<sub>4</sub> CORNER)

VERIFY LOCATION

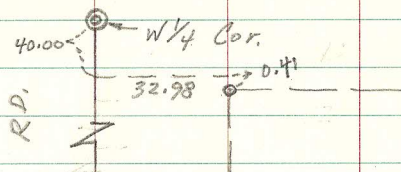

HILLVIEW

ROAD

