


SECTION 25, T30, R22
(Checking Location SE. corner)

December, 1976

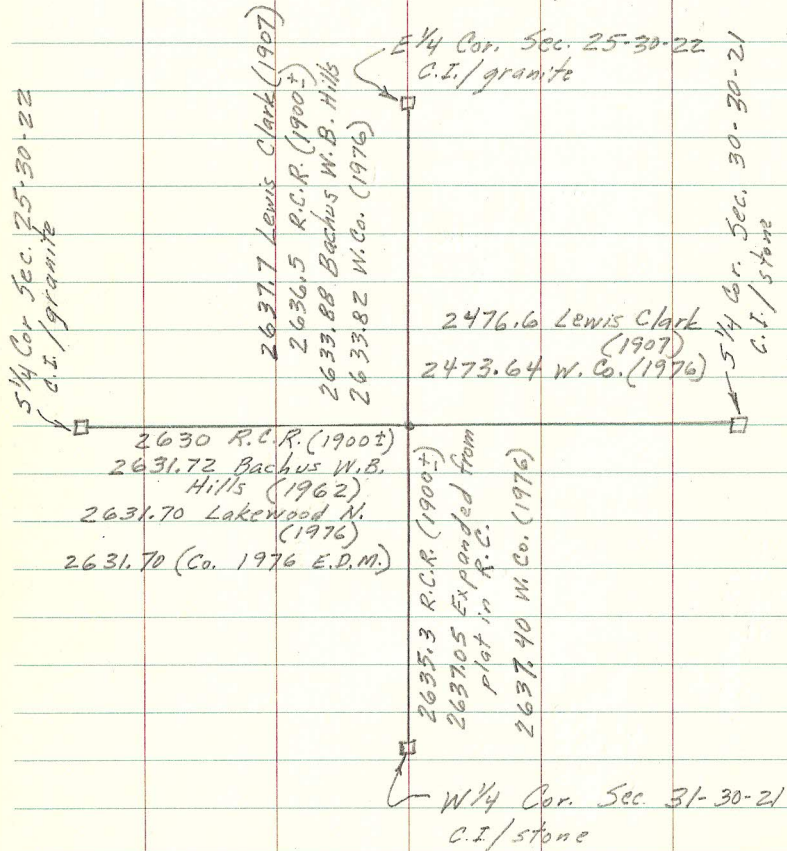

Mc GILL'S CORNER
by James Simonet (1938)

