


SECTION 17, T30, R23

(Ties to E 1/4 Corner & SE. Corner)

SEE TIE BOOK
FOR MORE TIES

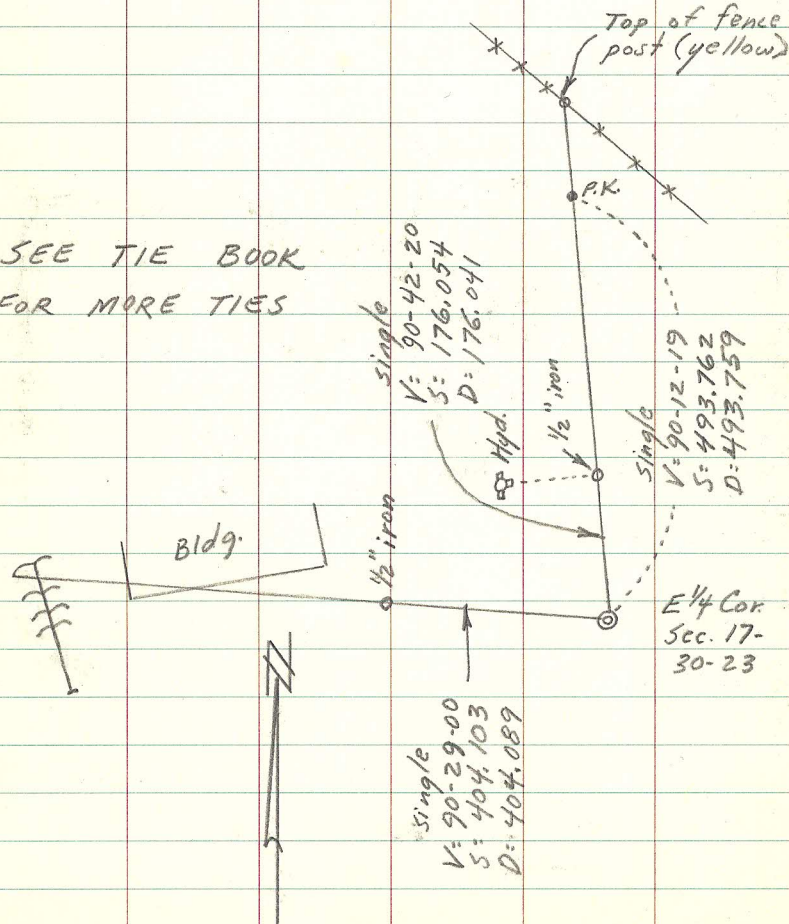

March 21, 1978

R.M. - M.F. - P.K.

71

