


SECTION 4, T29, R23

(Ties to N¹/₄ Corner,
NW Corner, and
W¹/₄ Corner)

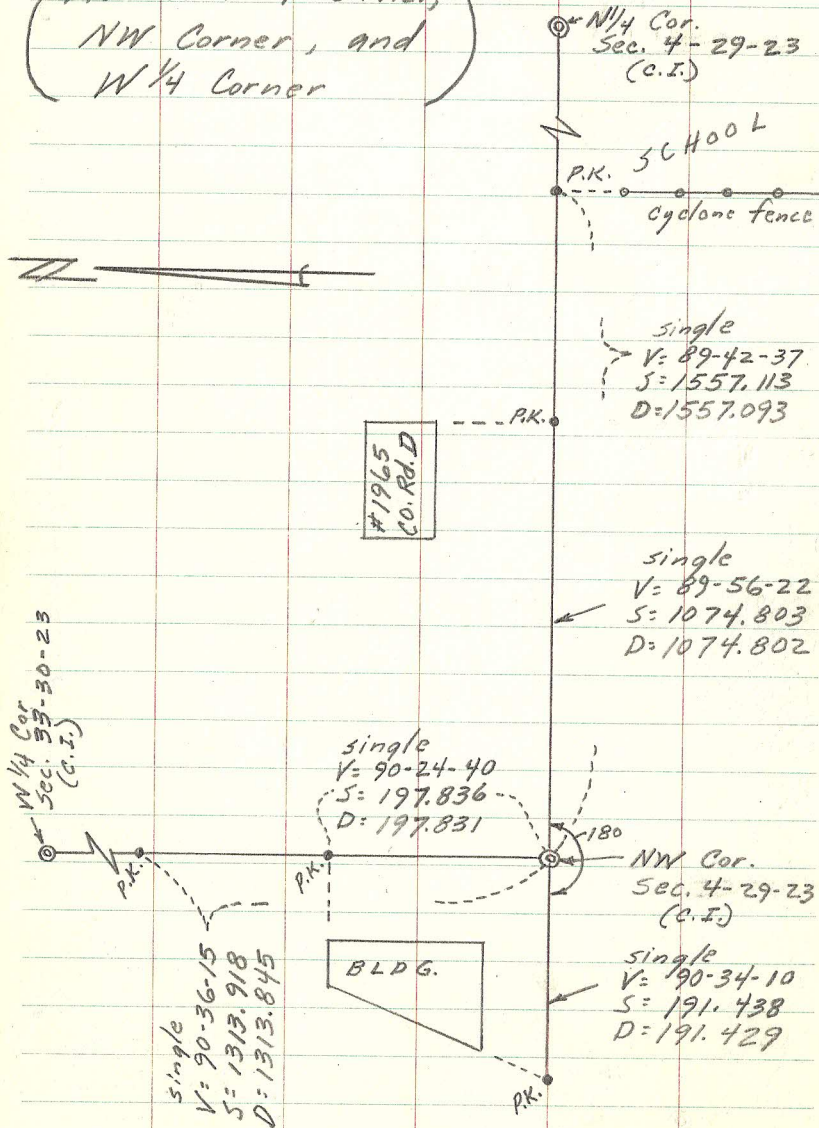

March 17, 20, 1978

72

R.M. - MF - PK

