OPEN SPACE
(Part of Gov't. Lot 1, Sec. 3, T30, R22 NEly of road)

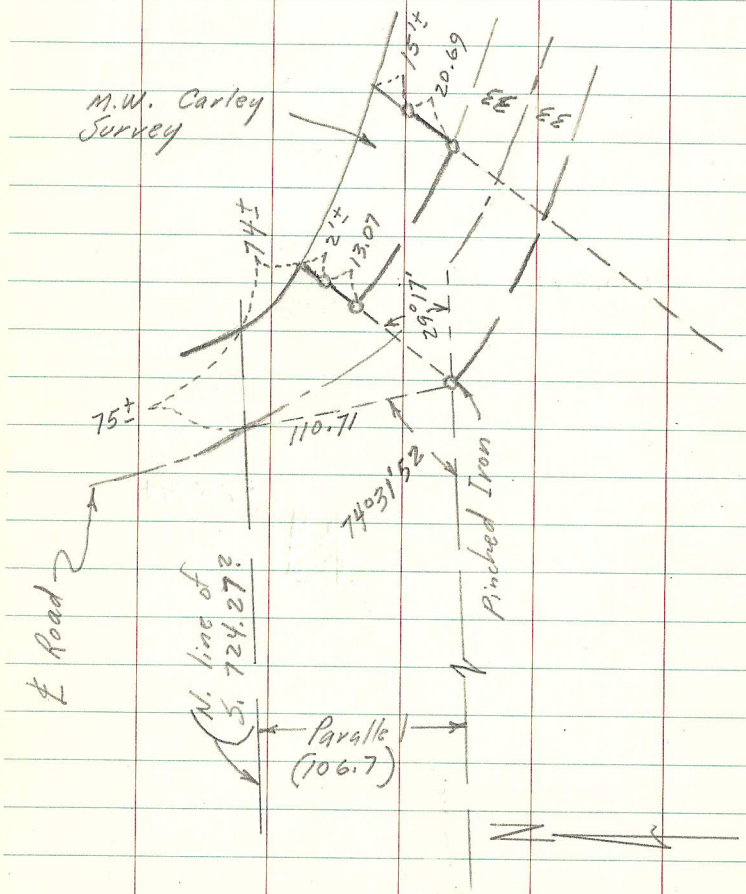

R.M.
M.F.
B.W.
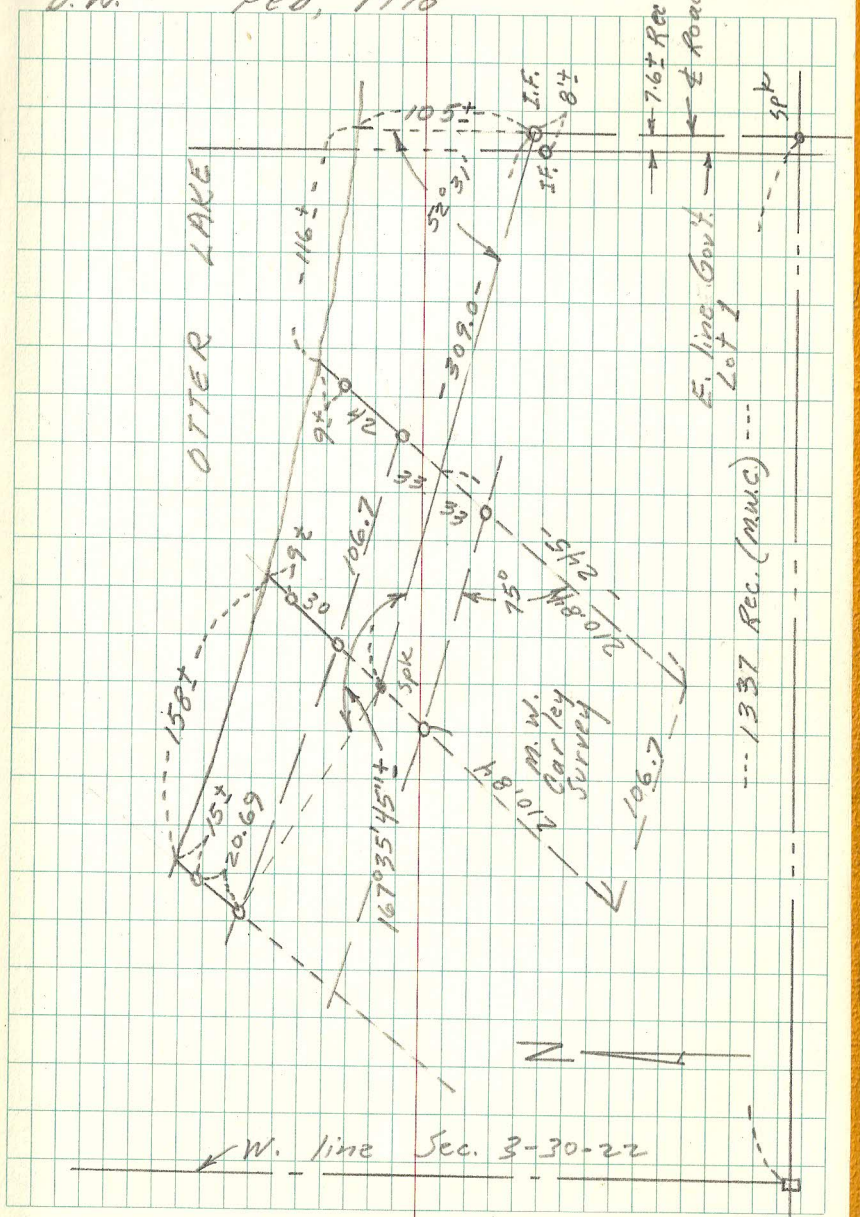
Feb, 1978