



SECTION 34, T30, R22.

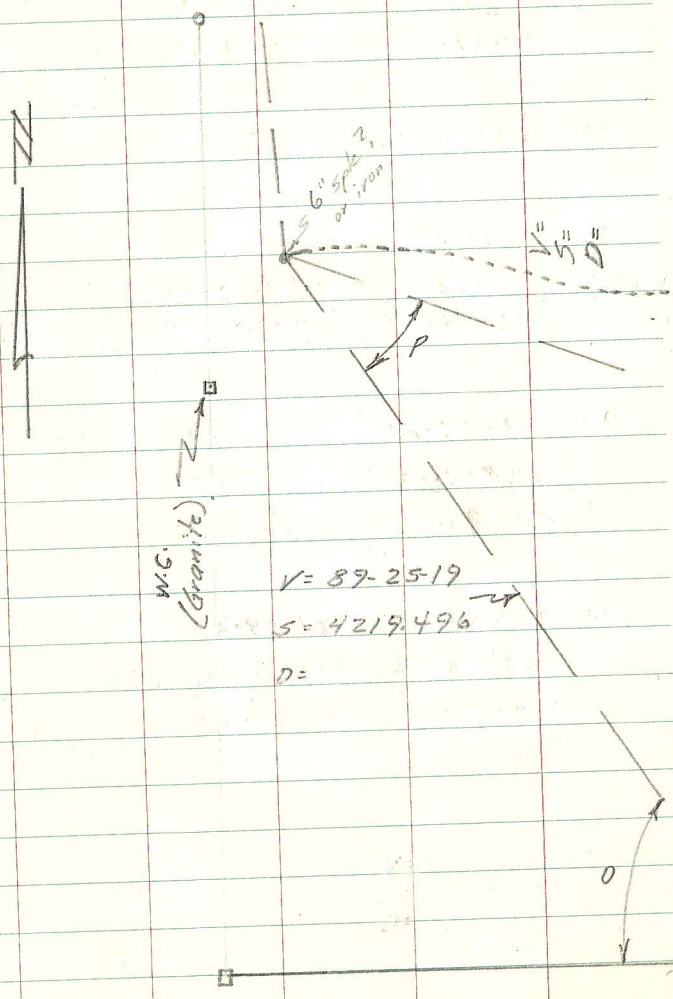

W.C.
(Granite)

V = 89-25-19
S = 4219.496
D =

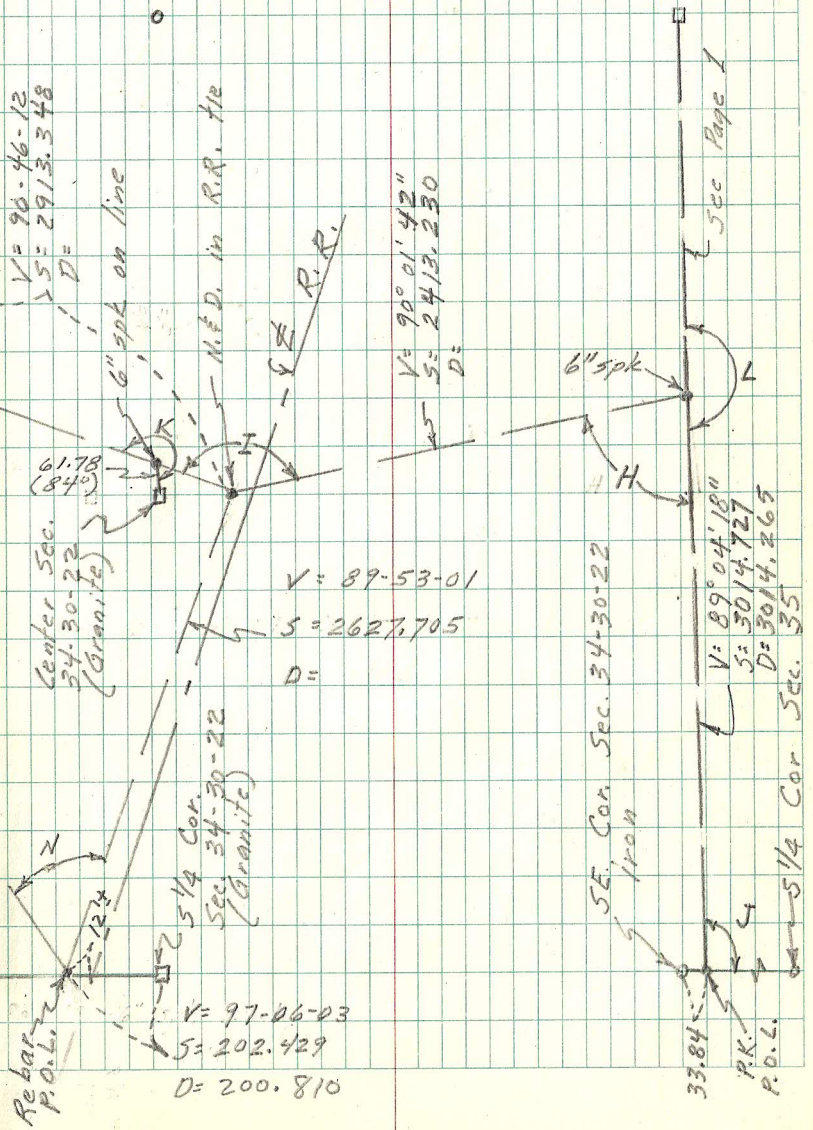

V = 96-46-12
S = 2913.348
D =

61.78
(84°)
Center Sec.
34-30-22
(Granite)

5/14 Cor.
Sec. 34-30-22
(Granite)

Rebar
P.O.L.
V = 97-06-03
S = 202.429
D = 200.810

V = 89-53-01
S = 2627.705
D =

V = 90° 01' 42"
S = 2413.230
D =

SE. Cor. Sec. 34-30-22
Iron

33.84
P.K.
P.O.L.
V = 89° 04' 18"
S = 3014.727
D = 3014.263
5/14 Cor. Sec. 35

Sec Page 1