


SECTION 5, T29, R23.

(VOID)

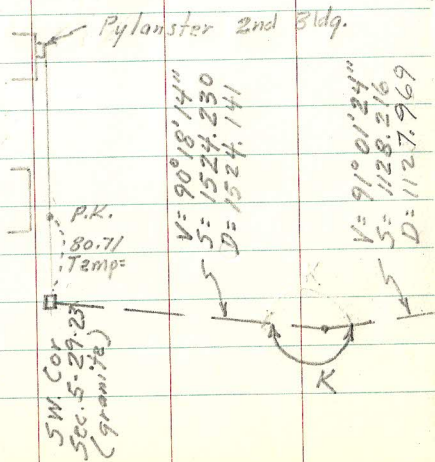

Temp.
Aug. 7, 1974

Sunny

R.F.M.
P.K. Jr. 6
R.W.

