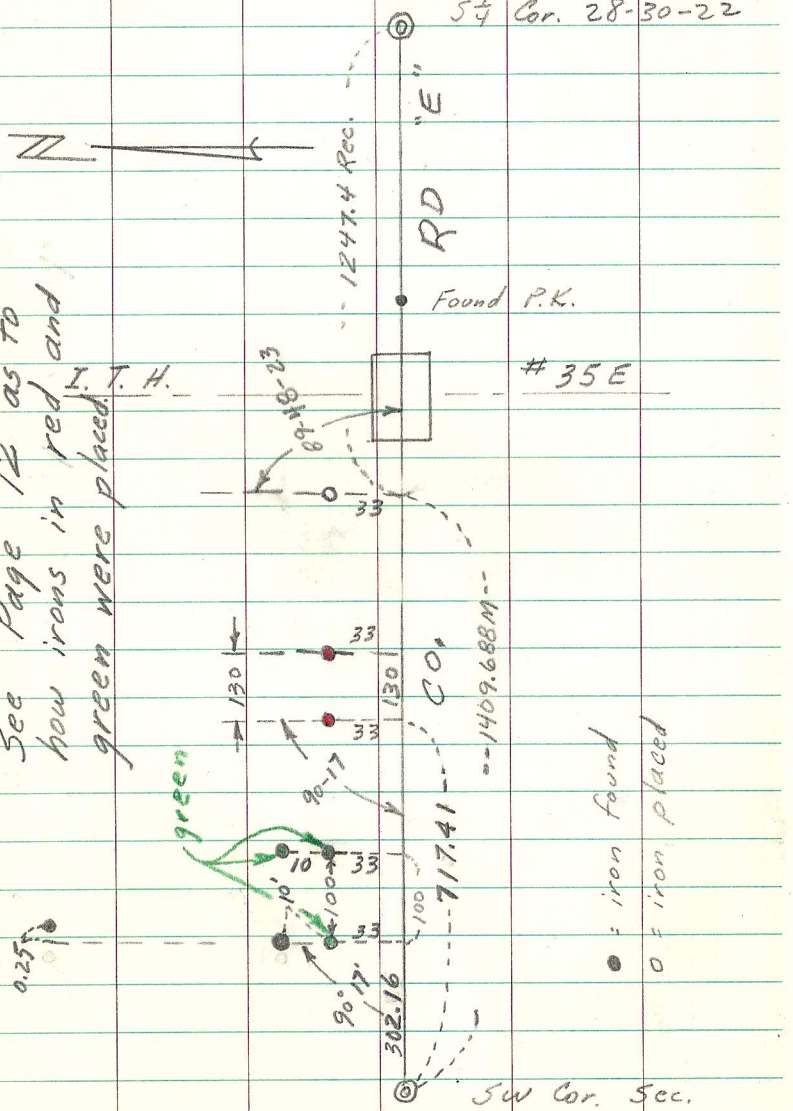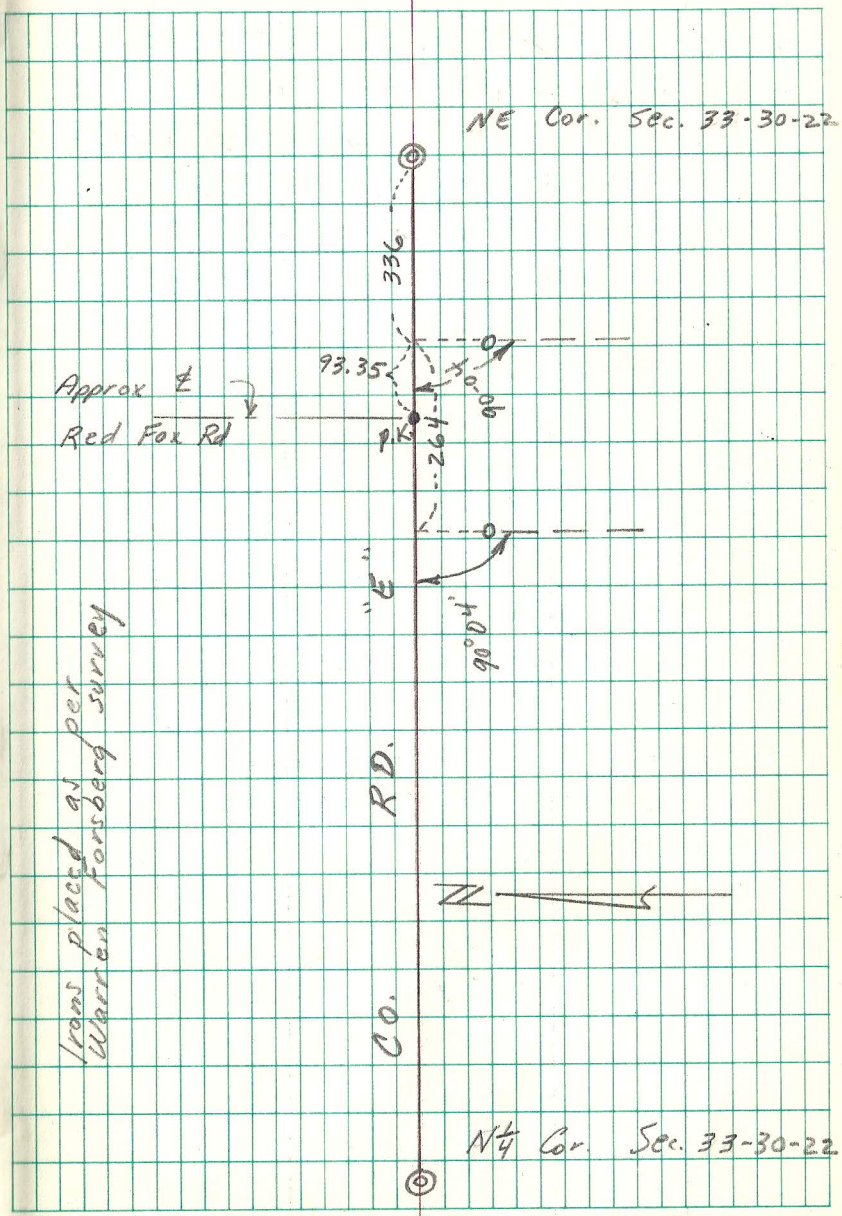Replacing Irons Sec. 28-30-22 & Sec. 33-30-22 (Co. Rd. "E")