Irons shown in red were placed as per location as per Milner W. Carley & Assoc. survey. Their survey used a brass plug west of the granite as the section corner (See ties to monu. No. 267). As they are placed, they do not match the legal description.
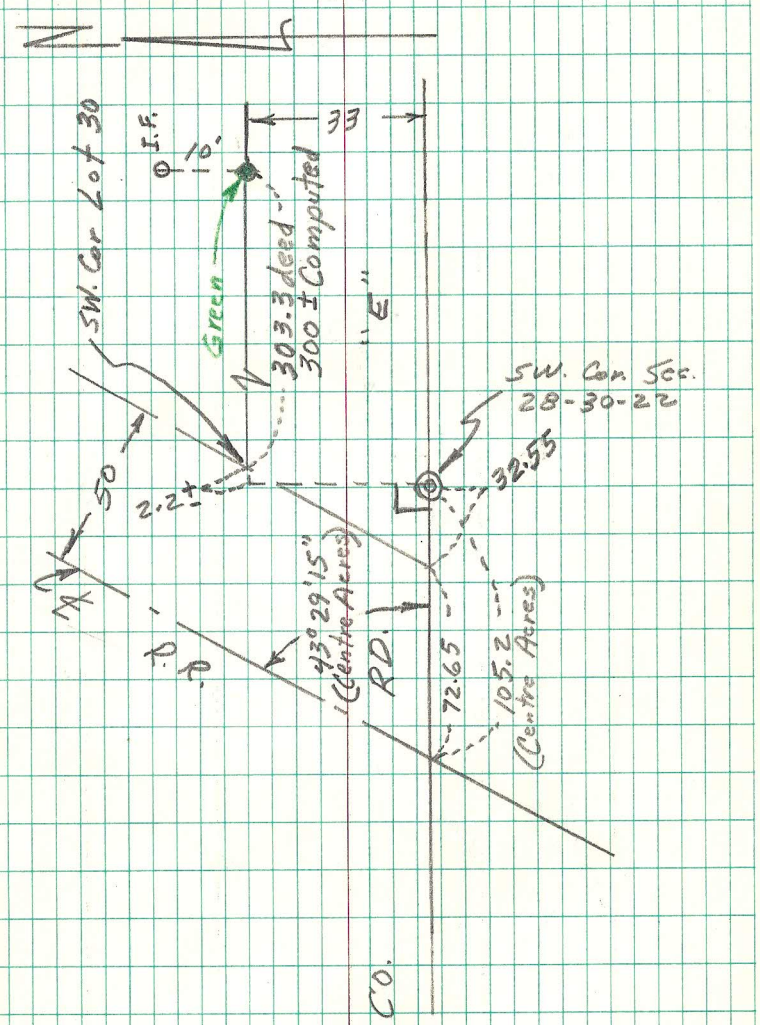
Irons shown in green were placed as stated above but were moved west to match the iron found 43' from ℄ as per Mr. Joe Valento had insisted. Neither as is or as Milner Carley survey, they do not match the legal description because of R.R. R/w.