


(Cont.)

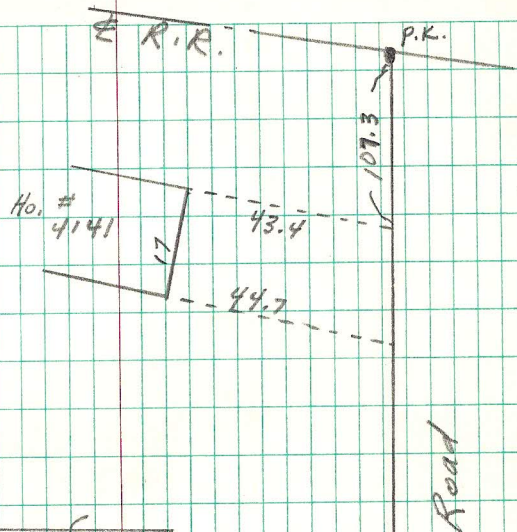

Co. Assessor estimates ho. #4130
was built about 1900±

