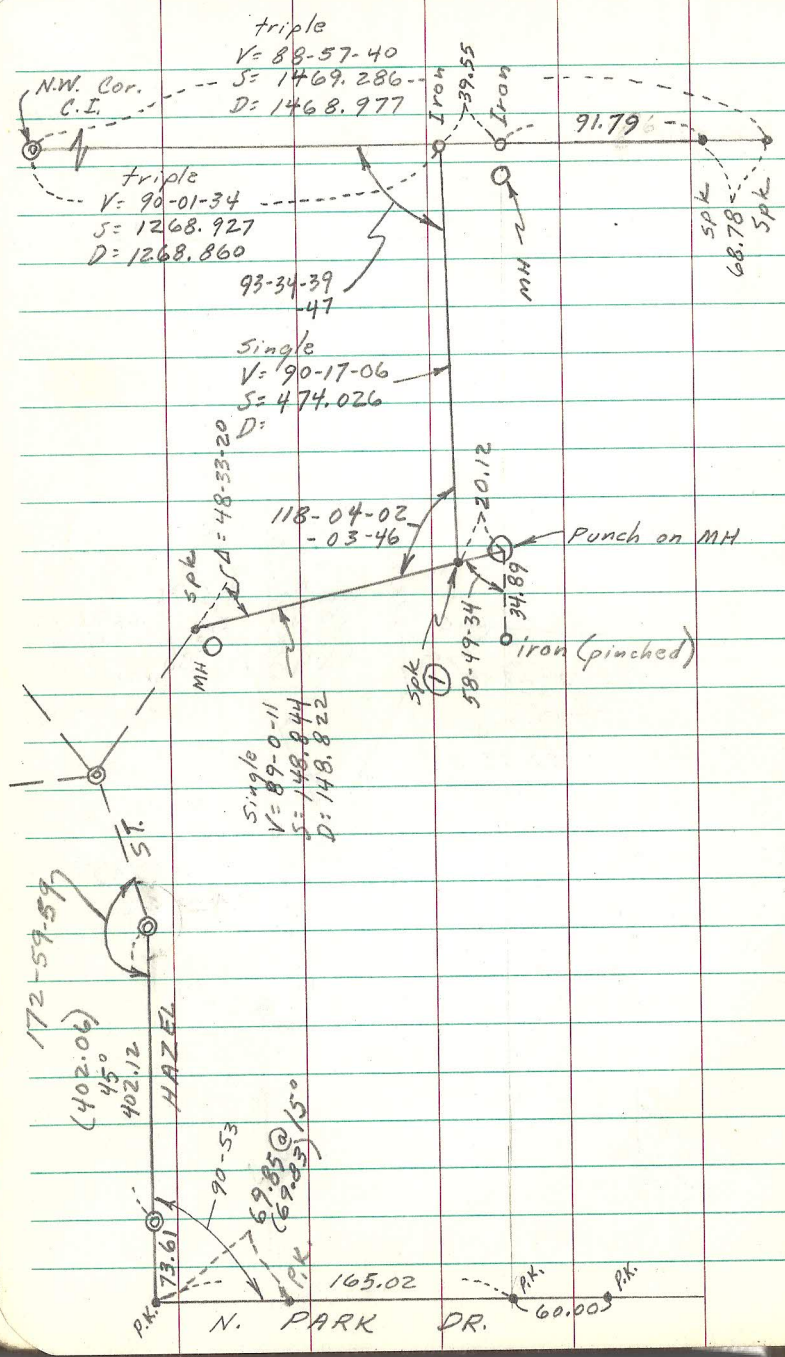
triple
V= 88-57-40
S= 1469.286
D= 1468.977
N.W. Cor. C.I.
Iron
39.55
Iron
91.79
triple
V= 90-01-34
S= 1268.927
D= 1268.860
93-34-39
-47
MH
5pk
68.78
5pk
Single
V= 90-17-06
S= 474.026
D:
Δ= 48-33-20
118-04-02
-03-46
20.12
Punch on MH
5pk
34.89
MH
5pk
58-49-34
iron (pinched)
Single
V= 89-0-11
S= 148.944
D= 148.822
ST.
172-59-59
(402.06)
45°
402.12
HAZEL
90-53
69.85@15°
(69.83)
P.K.
73.61
P.K.
165.02
P.K.
P.K.
60.00
N. PARK DR.

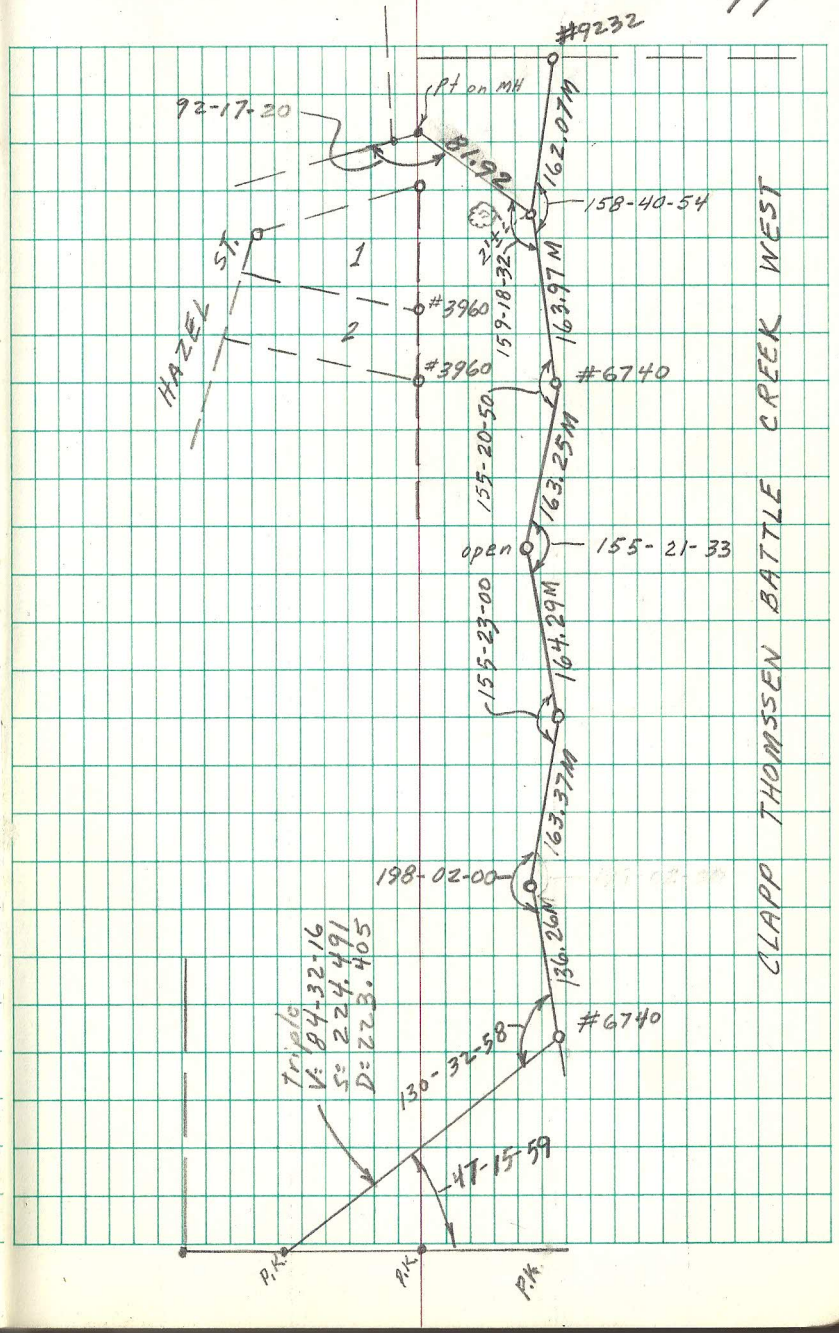
#9232
Pt on MH
92-17-20
81.92
162.10M
158-40-54
ST.
1
2
HAZEL
#3960
159-18-32
163.97M
#3960
#6740
155-20-50
163.25M
open
155-21-33
155-23-00
164.29M
198-02-00
163.37M
136.26M
#6740
130-32-58
41-15-59
Triple
V= 84-32-16
S= 224.491
D= 223.405
P.K.
P.K.
P.K.
CLAPP THOMSSEN BATTLE CREEK WEST