OPEN SPACE (LANGTON LAKE)

PART NW¼ Sec. 4-29-23
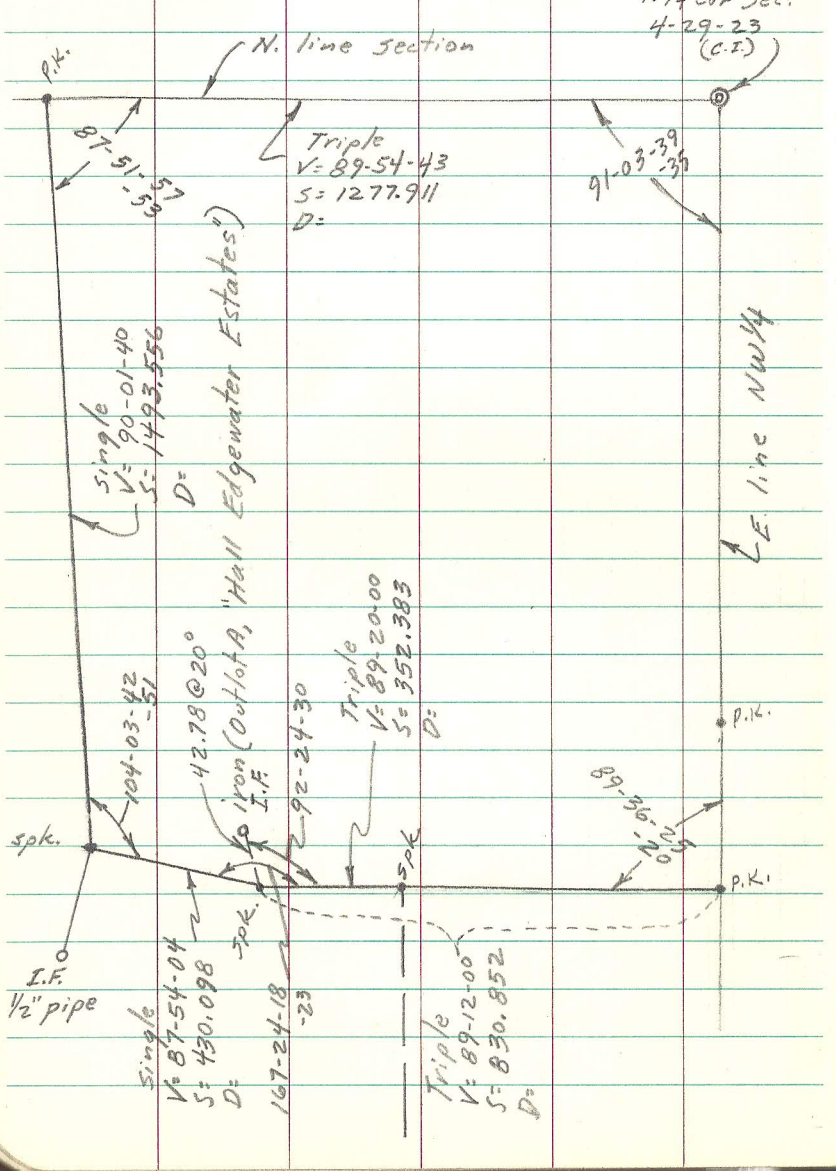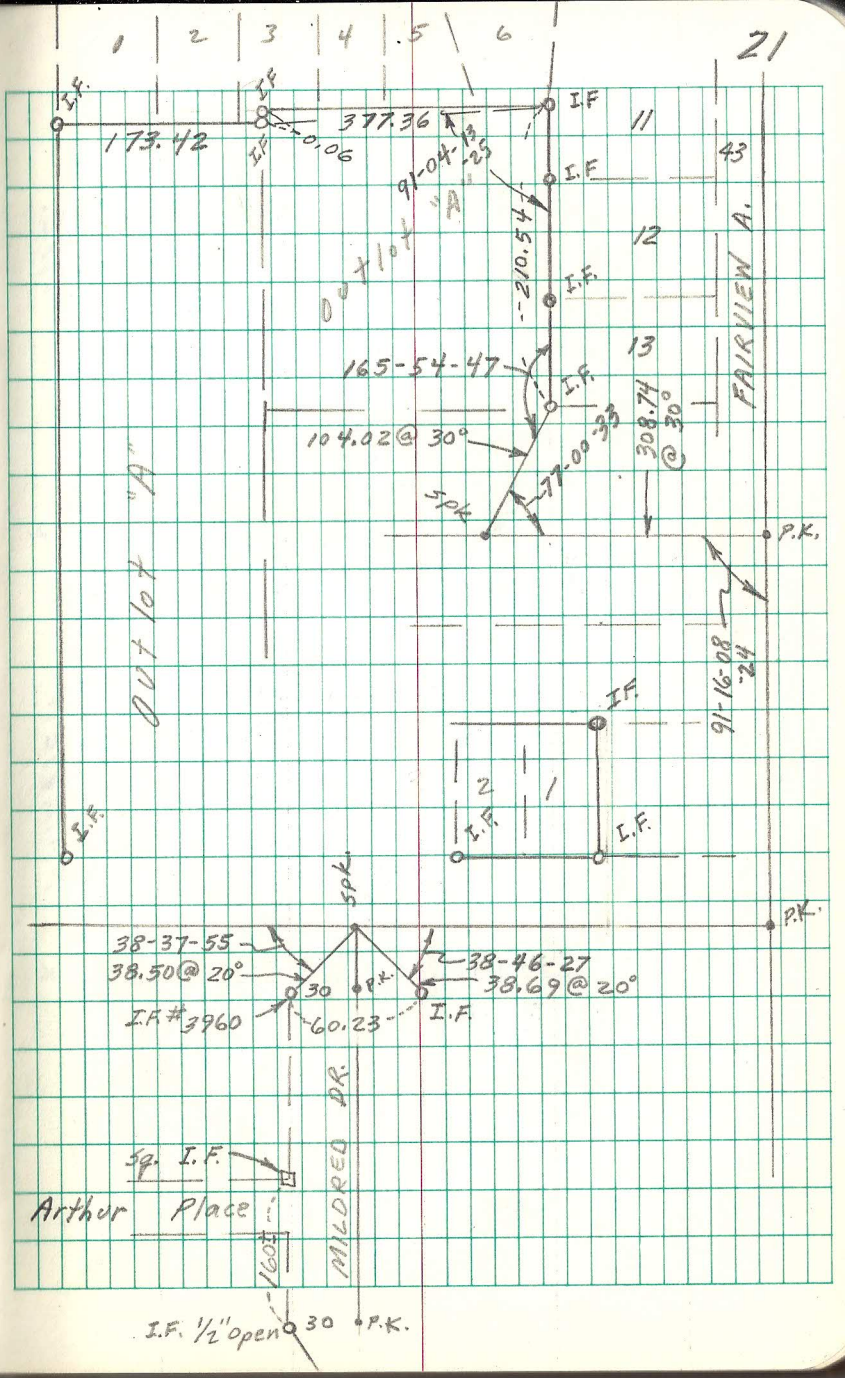
Crew: RM, P.K. P.D. Dec. 1978