


OPEN SPACE (LILYDALE)  
SEC. 14, T 28, R 23

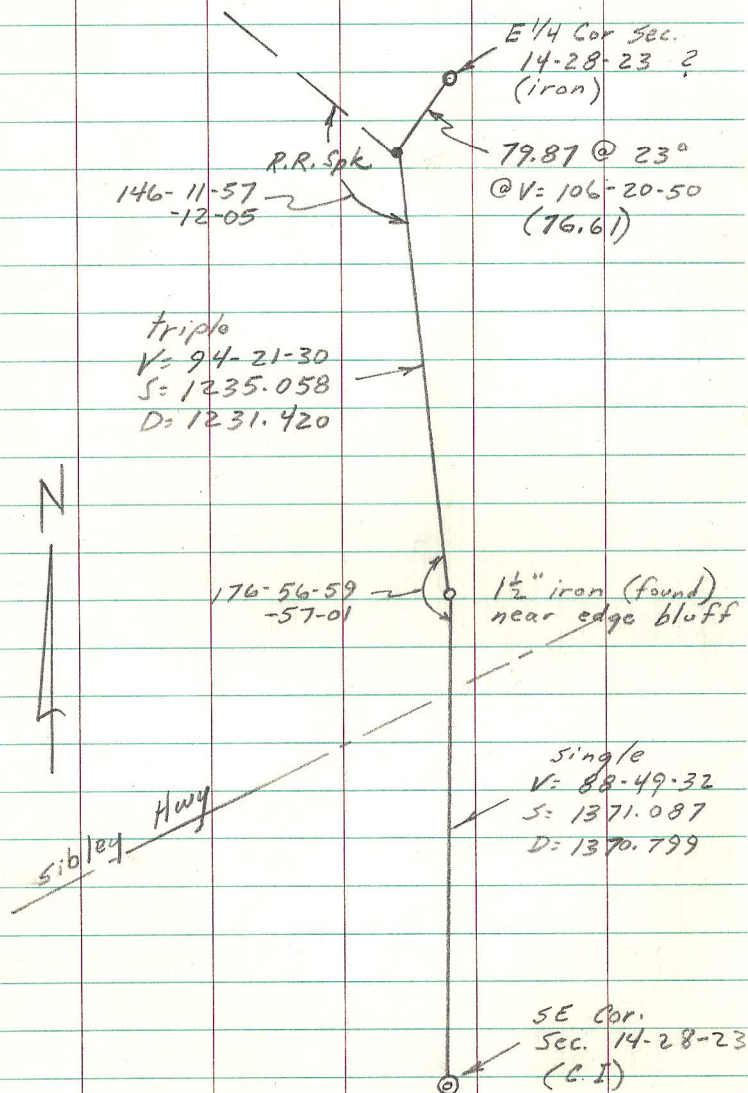

Crew: R.M. Jan-Feb 1979

23

P.K.  
P.D.  
R.C.?

