Lots 6 & 15, Block 3,
Long's 2nd Add.
D.C. MN.

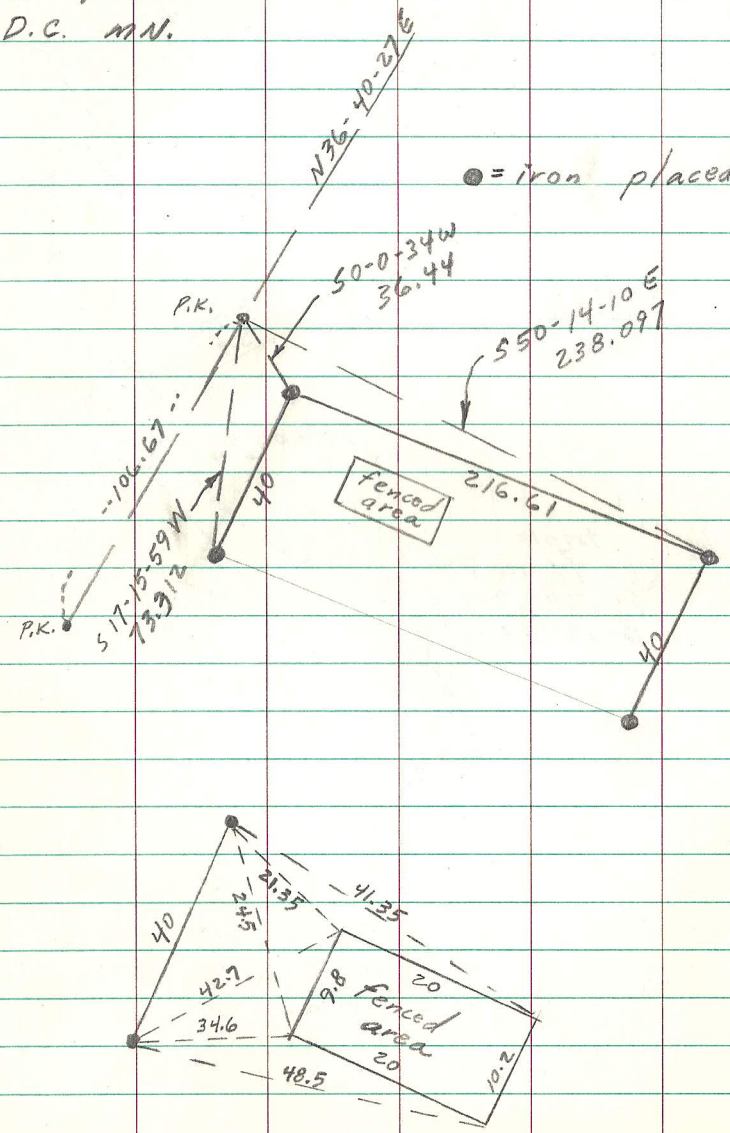
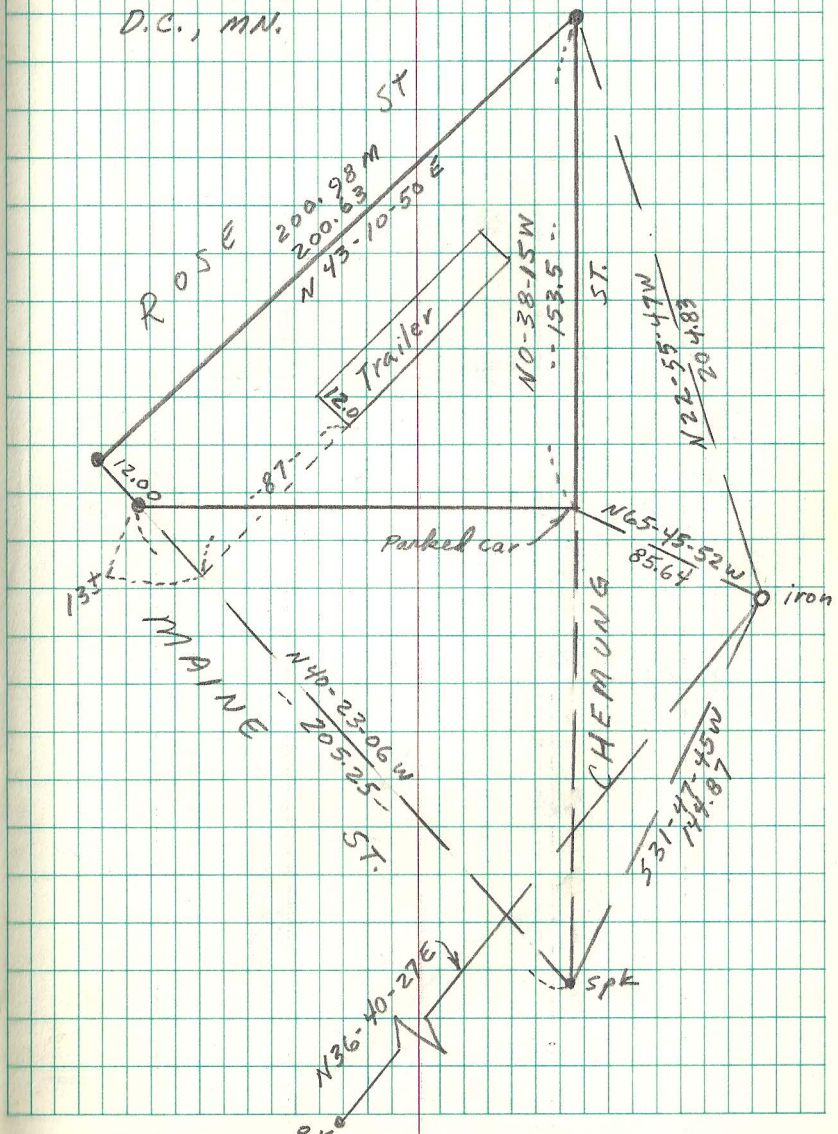
Lots 1, 2, 3, Block 6,
LILLY DALE ADD.
D.C., MN.