


OPEN SPACE (SOD FARM)  
 SE 1/4 SEC. 11, T29, R22

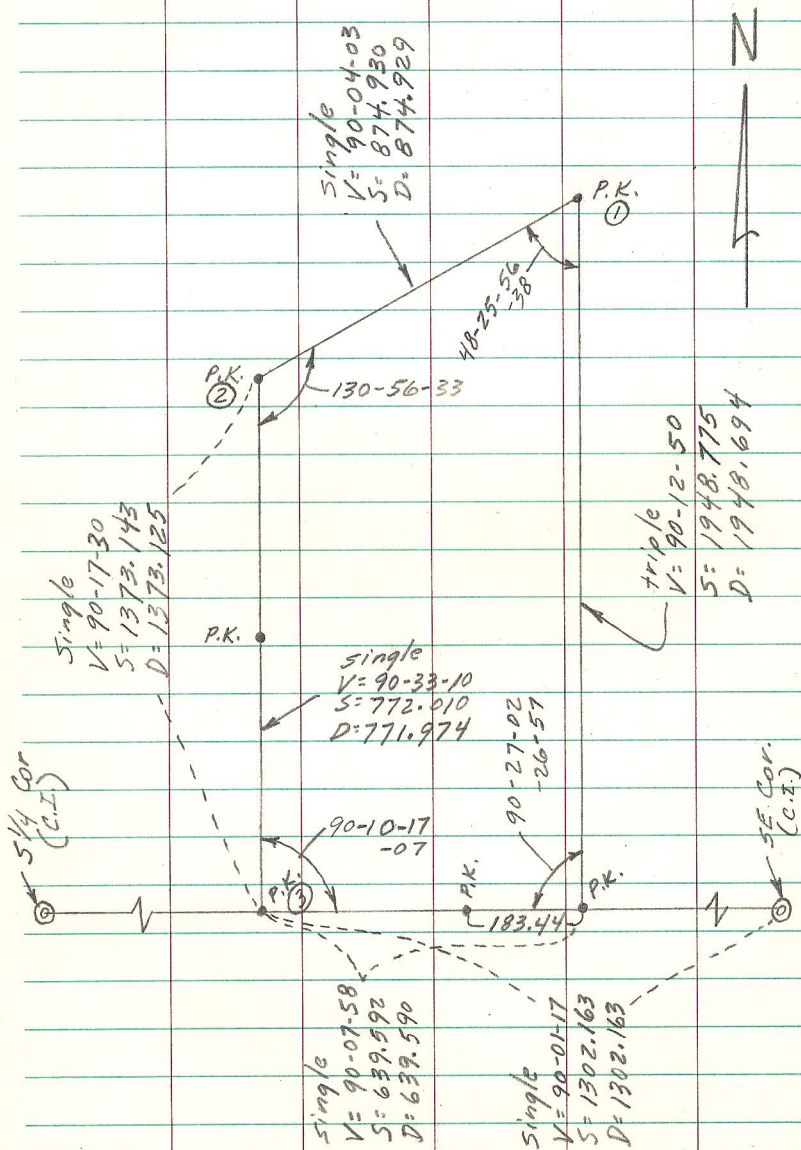

TIES to TRAVERSE POINTS

