OPEN SPACE (CARVER & FISH CREEK)

SECTION 24, T28, R22.

o = iron monument and cap

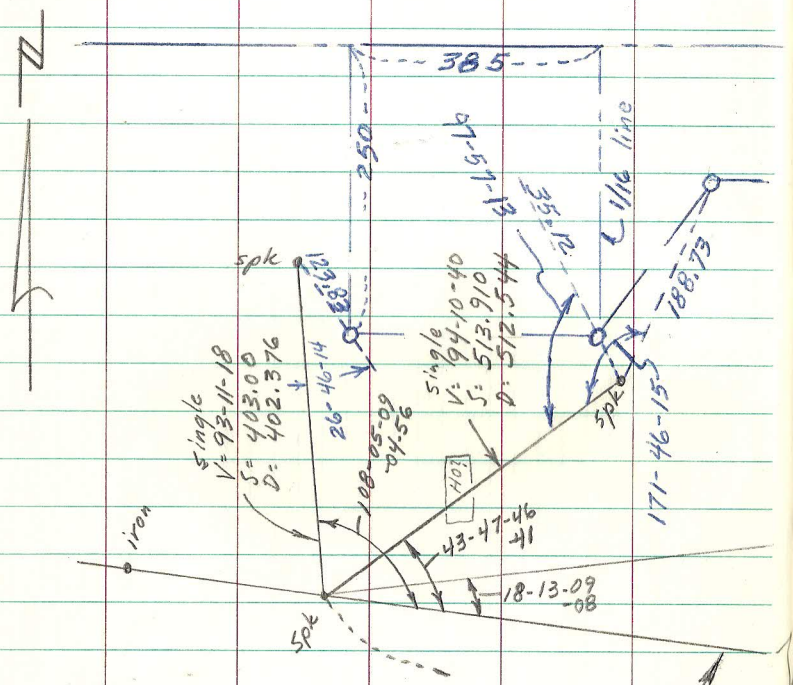

SEE SEC. 24, T28, R22 in LITTLE CANADA & McLEAN Page 16
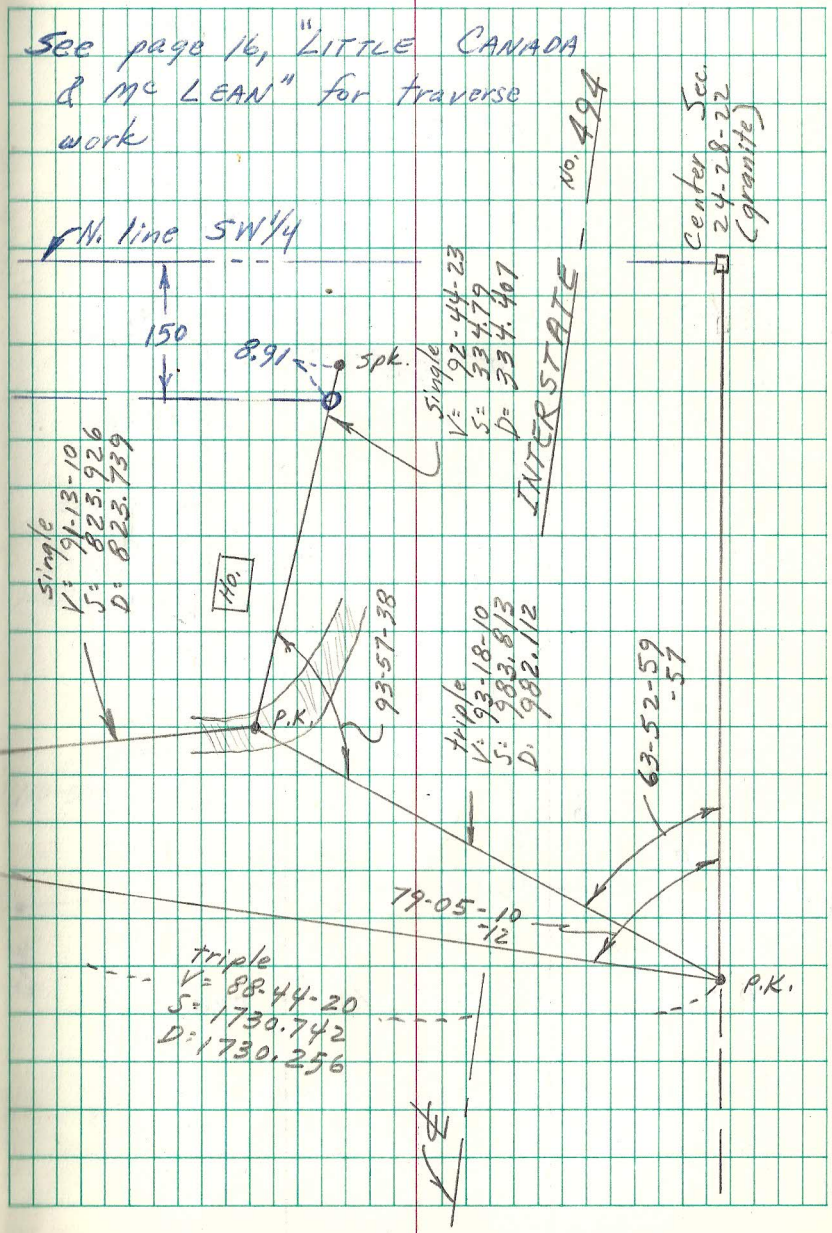
See page 16, "LITTLE CANADA & McLEAN" for traverse work