June, 1980 R.M. P.K. B.K.

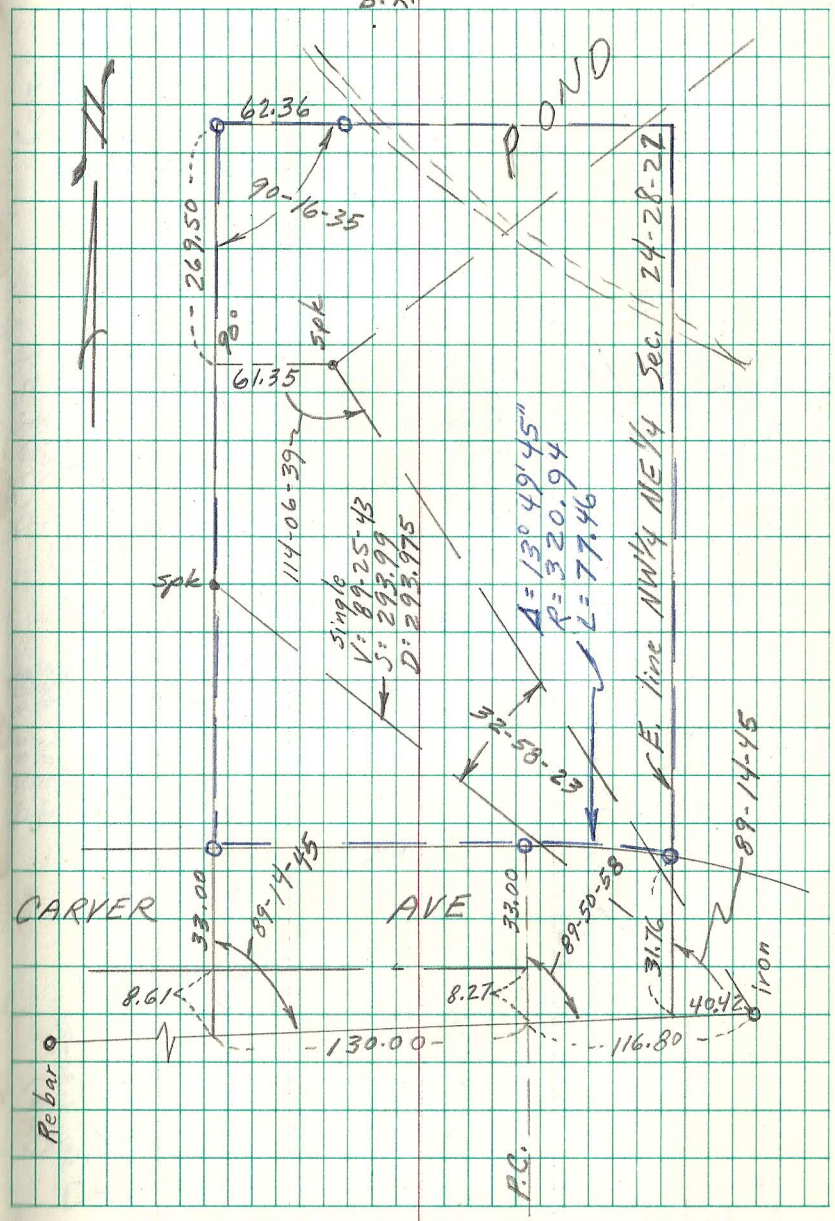

o = iron monu. & plastic cap →

See page 16, "LITTLE CANADA & Mc Lean" for traverse work.