R.M.
M.F.
P.K.
R.W.

Fall, 1974

OPEN SPACE
SW 1/4 SEC. 3-30-23

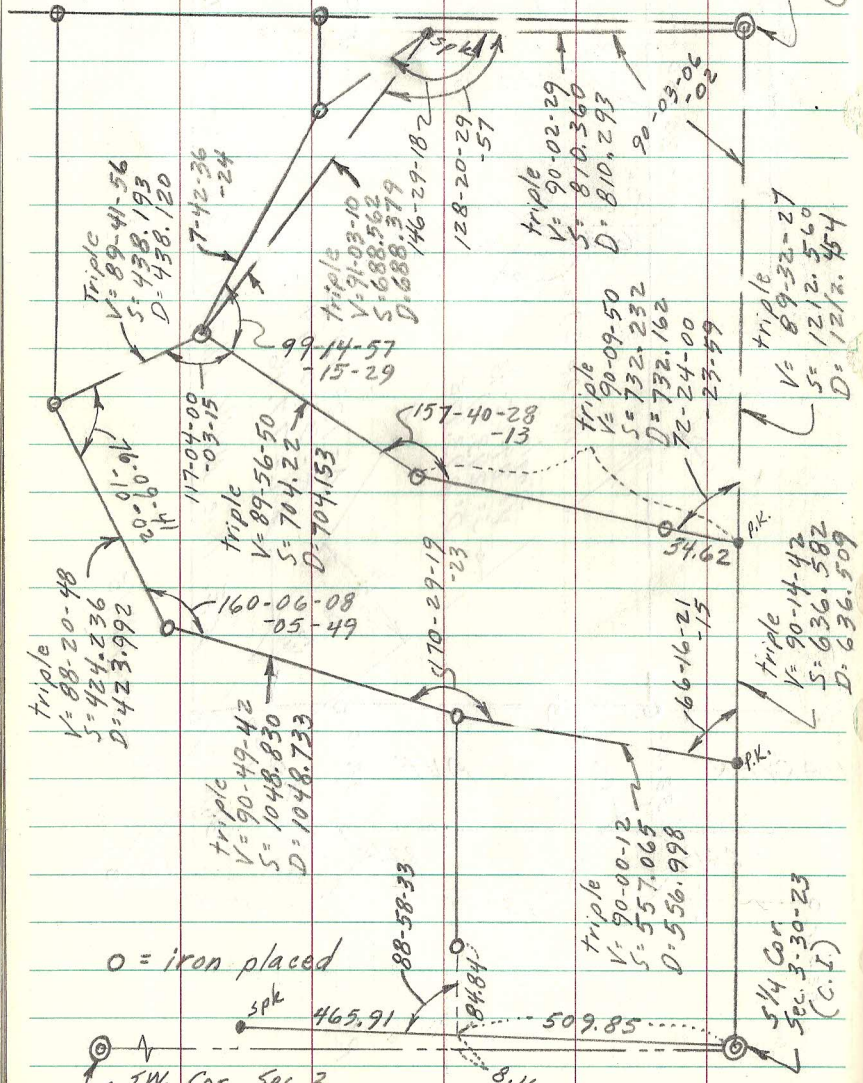
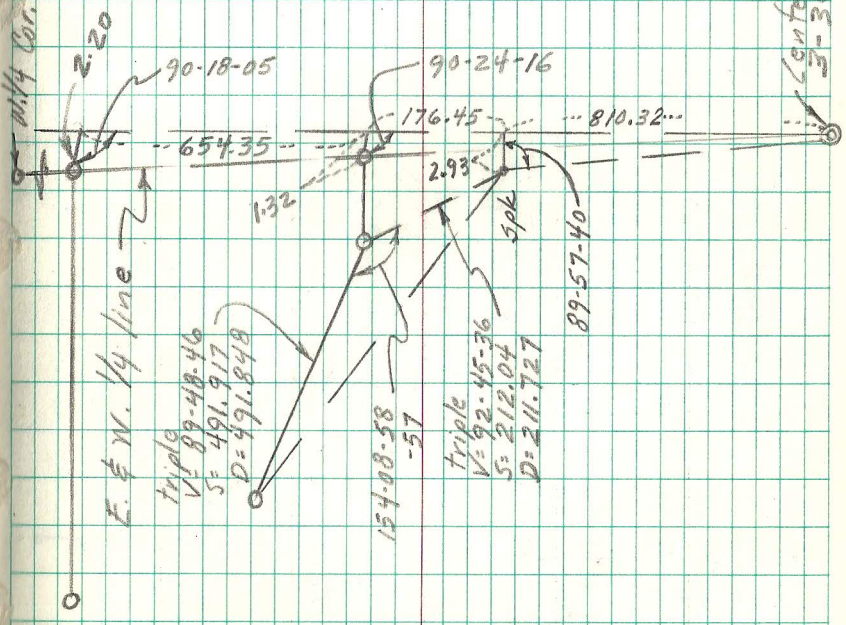
See "Moundsview," survey book, page 30 For SECTION TRAVERSE WORK.