OPEN SPACE (KELLER GOLF COURSE)
SEC. 9-29-22

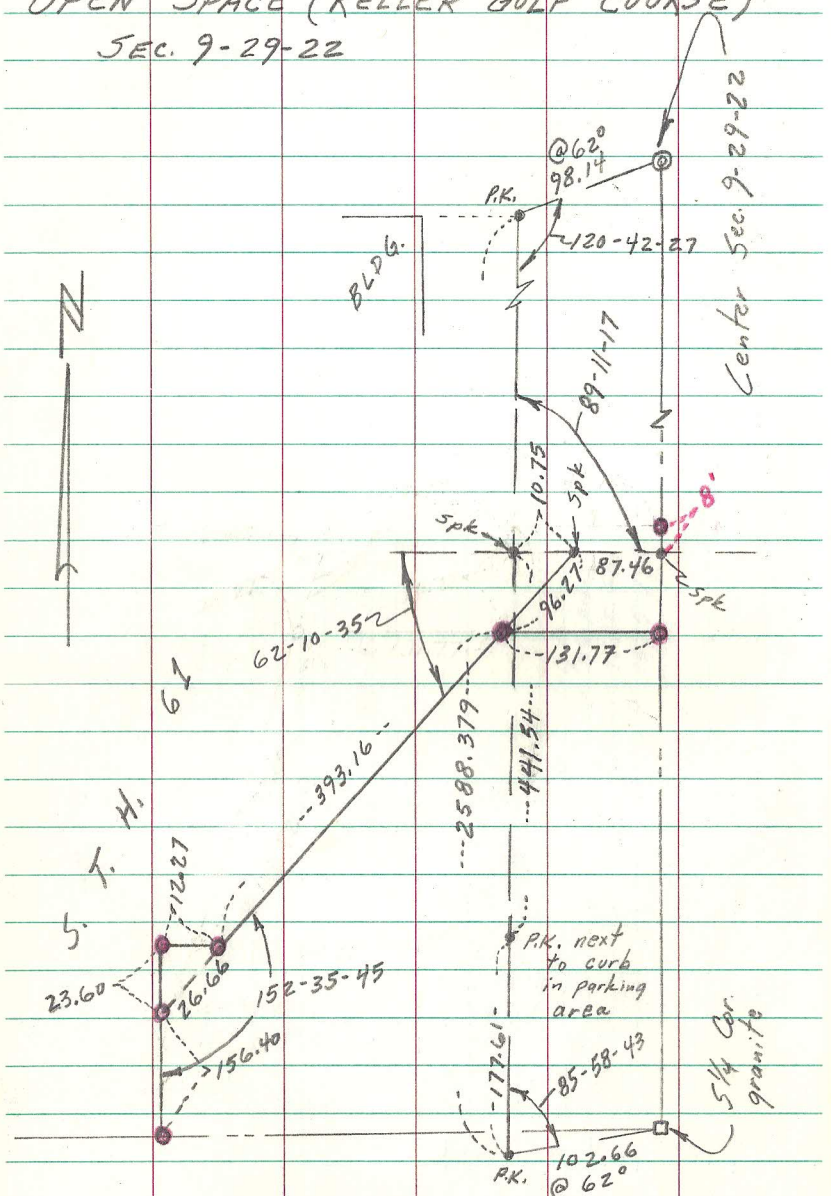

○ = 5/8" Rebar with plastic cap "RAMSEY COUNTY".

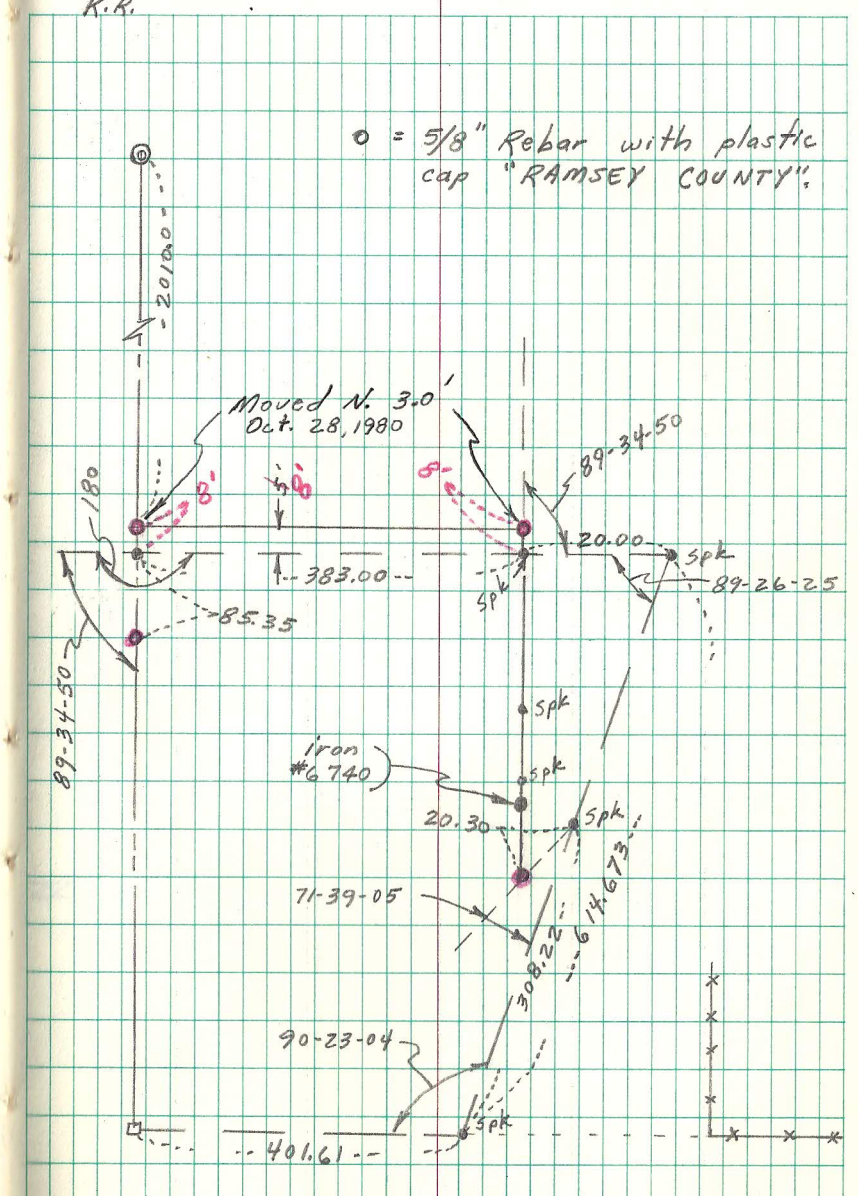

(OVER)