


OPEN SPACE (Snail Lake NW)

N 1/2 SEC. 23, T30, R23.

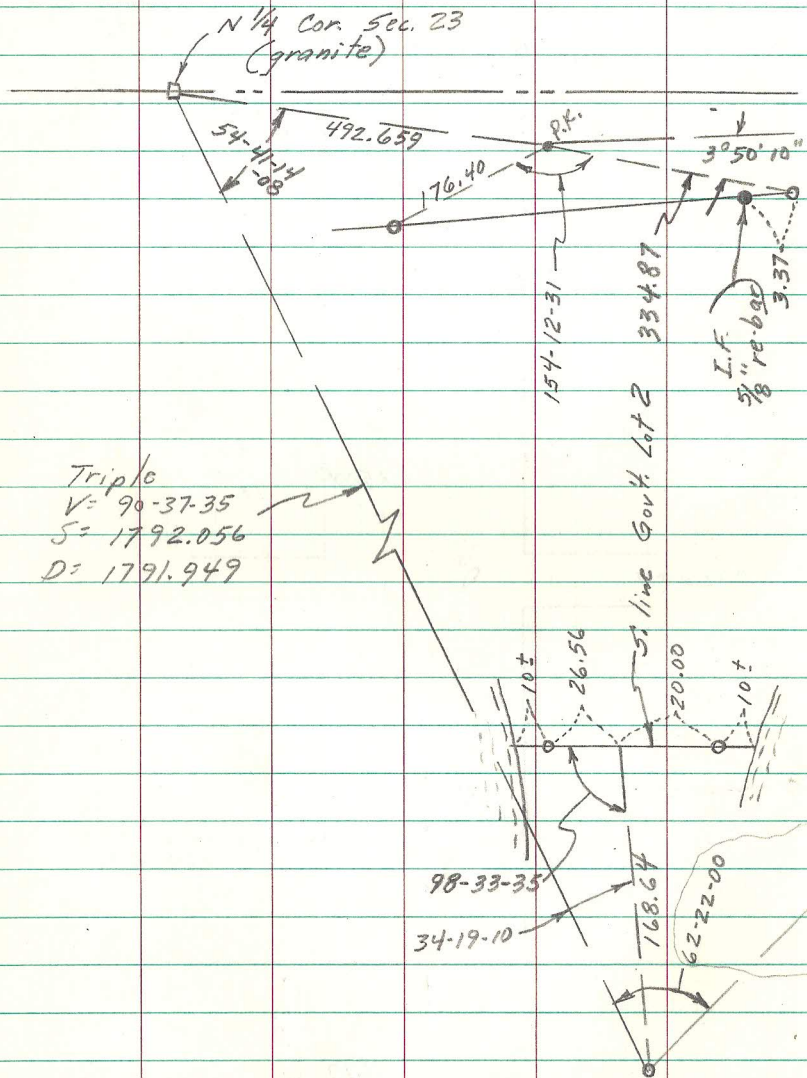

Triple
 $V = 90-37-35$
 $S = 1792.056$
 $D = 1791.949$

