OPEN SPACE (WOODVIEW)
PART S½ SECTION 13, T29, R23.

How irons were placed in field.
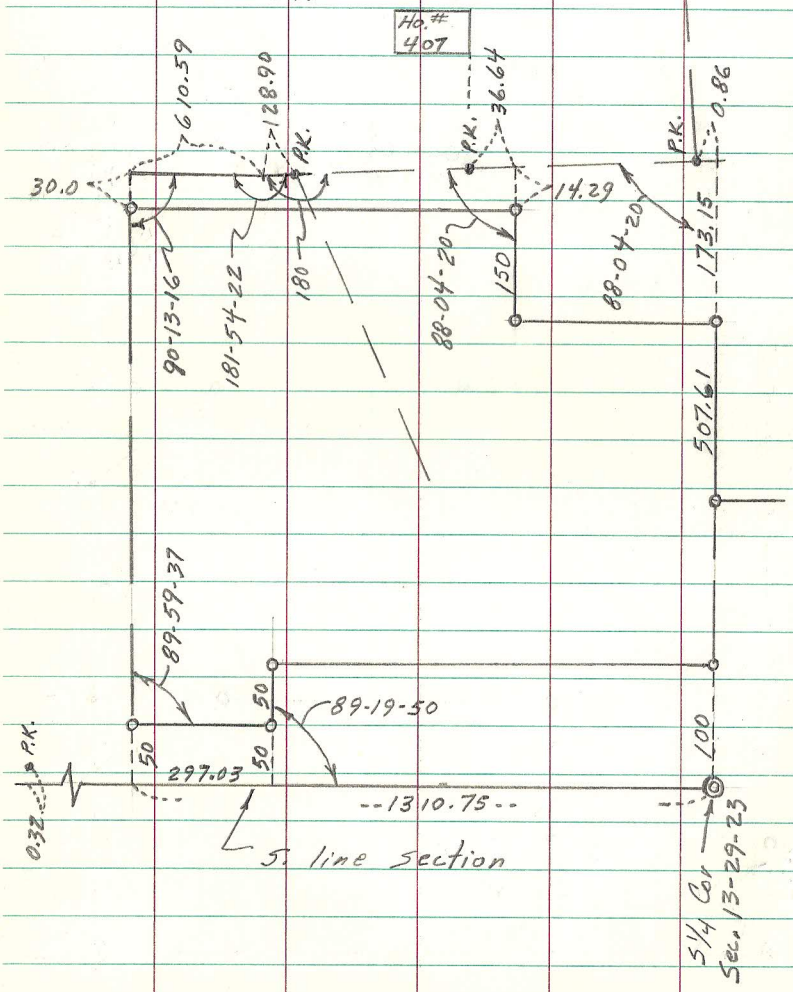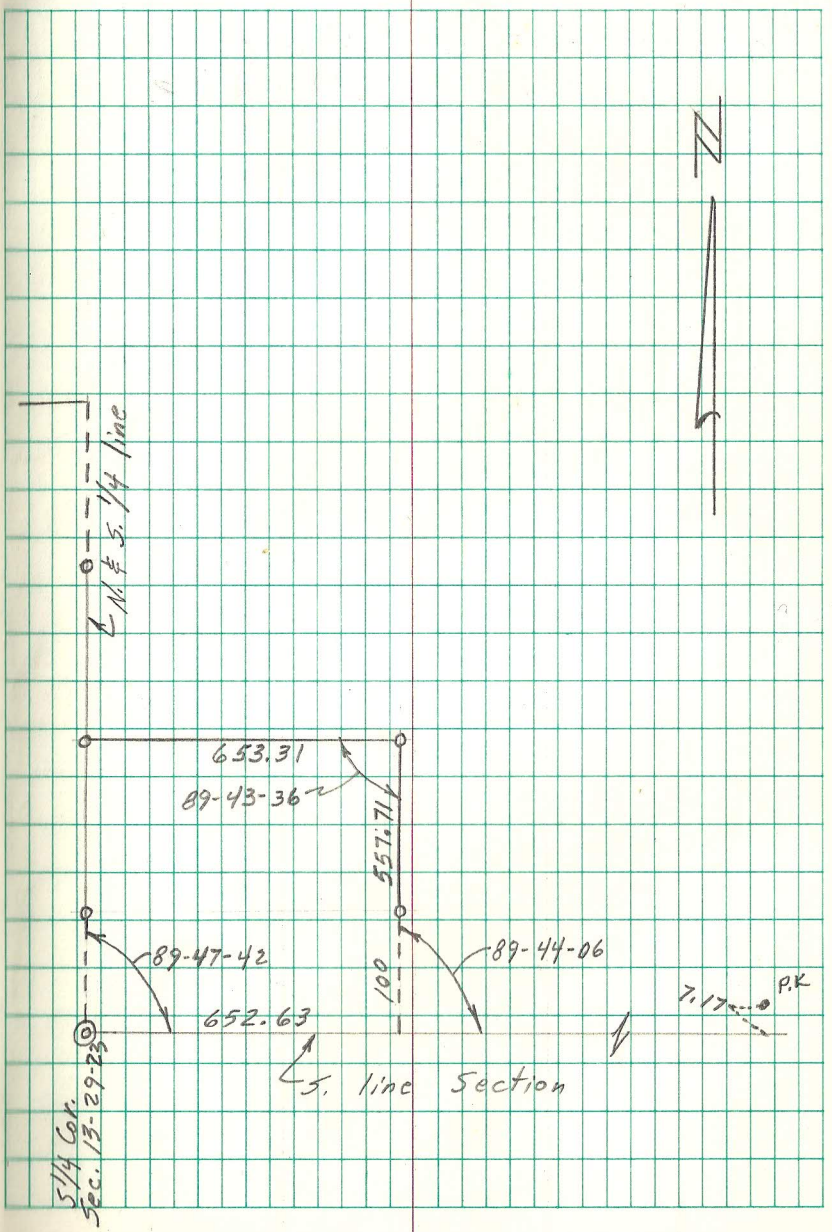
o = iron monument