

Replacement of SW Corner of  
Section 13, T29, R23.

R.M.  
M.K.  
K.R.  
July 20, 1981


43

triple  
V = 89-52-25  
S = 2631.578  
D = 2631.505

triple  
V = 90-11-52  
S = 2610.42  
D = 2610.959

W 1/4 Cor.  
Sec. 13-29-23

W 1/4 Cor.  
Sec. 24-29-23

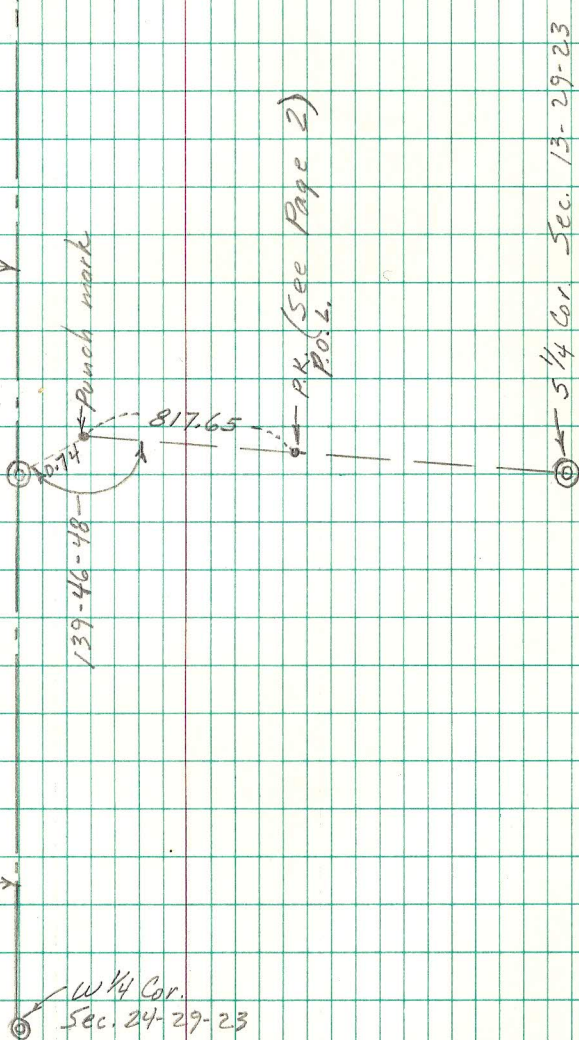

