OPEN SPACE (WILLOW LAKE)

See Sec. 33-30-22 for more info on section traverse

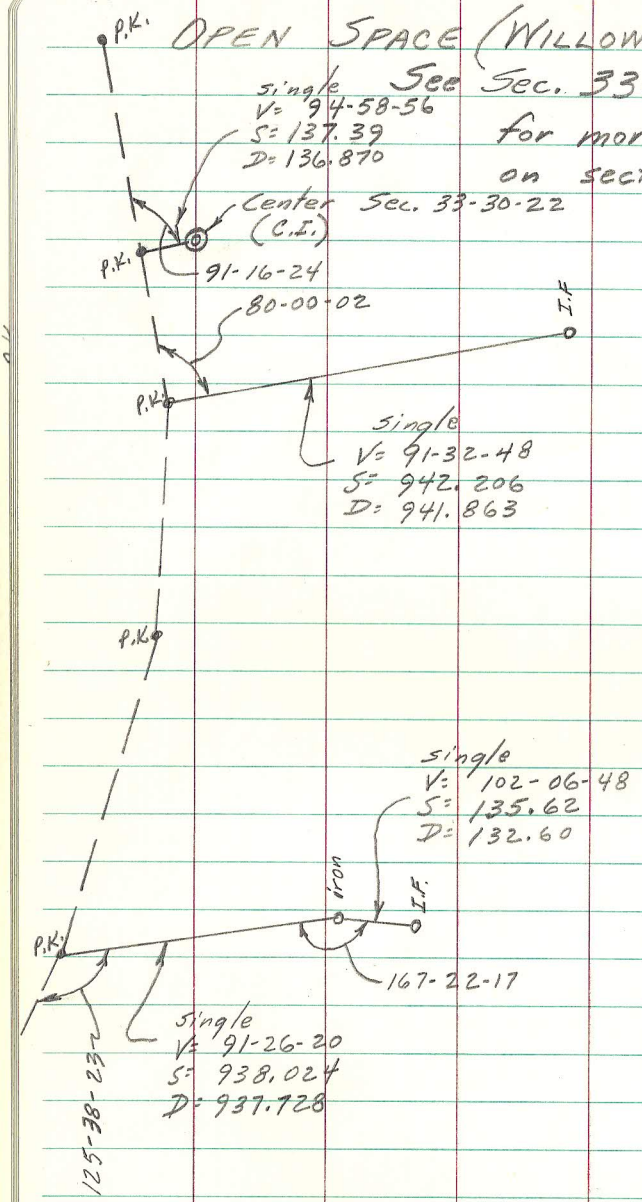

Nov. - Dec. 1981

R.M.
M.F.
P.D.
J.B.

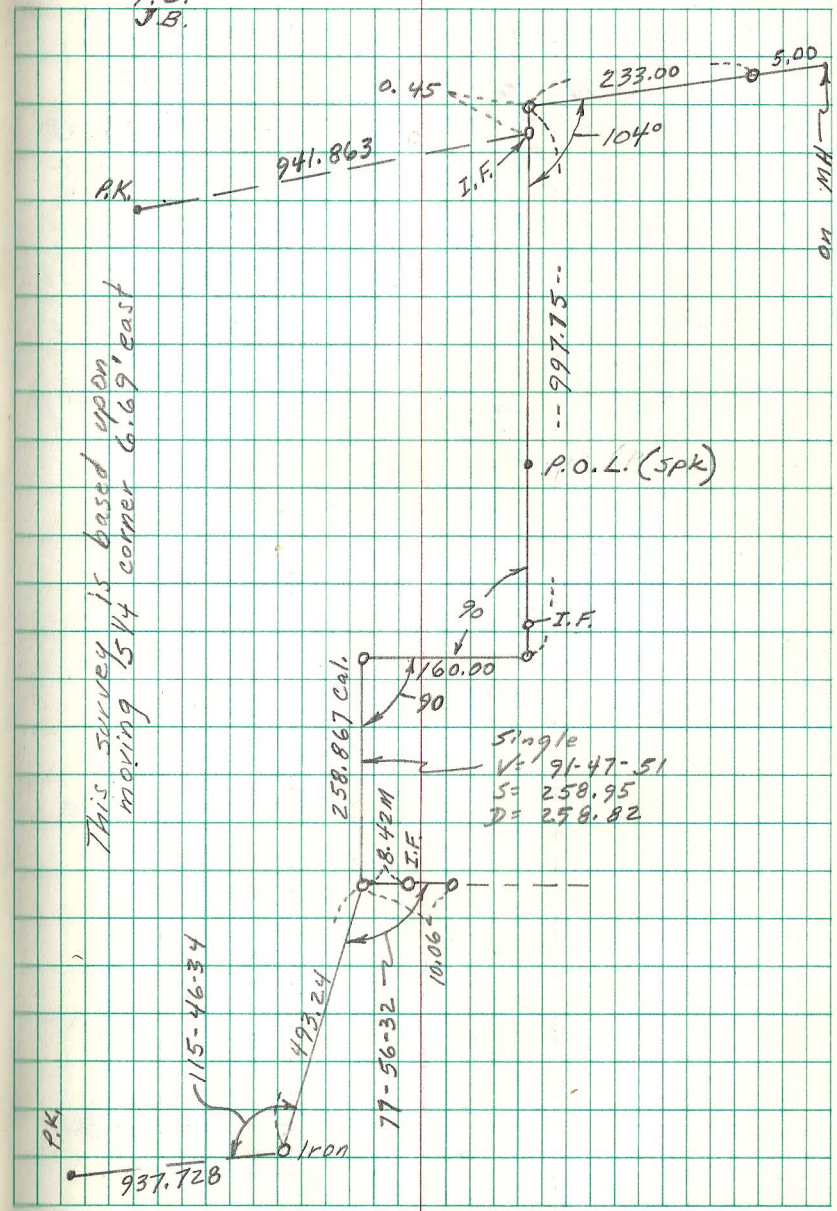

This survey is based upon moving 5 1/4 corner 6.69' east