R.M.
P.D.
D.S.

1-6-83 26°



# OPEN SPACE (Co. Ditch NO. 18)
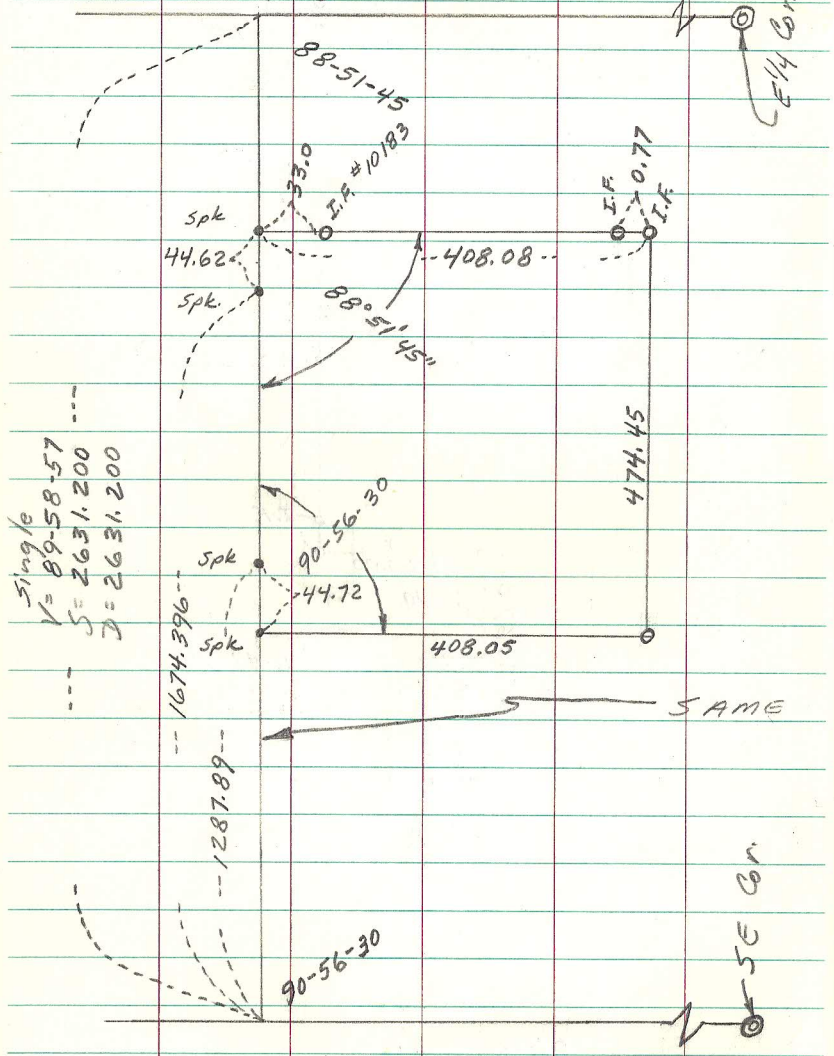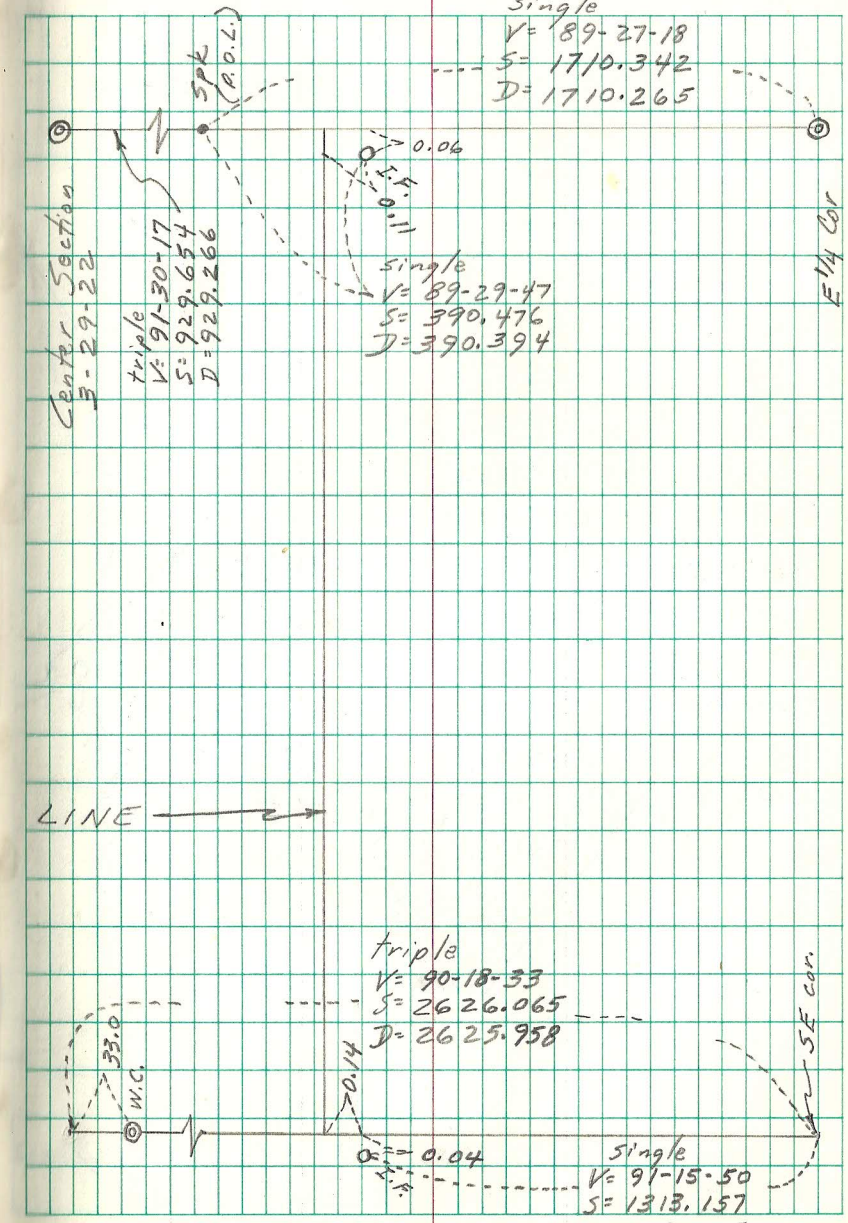
Part SE 1/4 Sec. 3-29-22