CHECKING NE. COR. AND E 1/4 COR. SECTION 11, T29, R22.


Granite monu. existed when plats of Castlewood (1915) and Nelson's Re-arrangement (1927) were made.

Sanitary sewer (N. St. Paul) went-in in 1954. This must of destroyed granite monument.
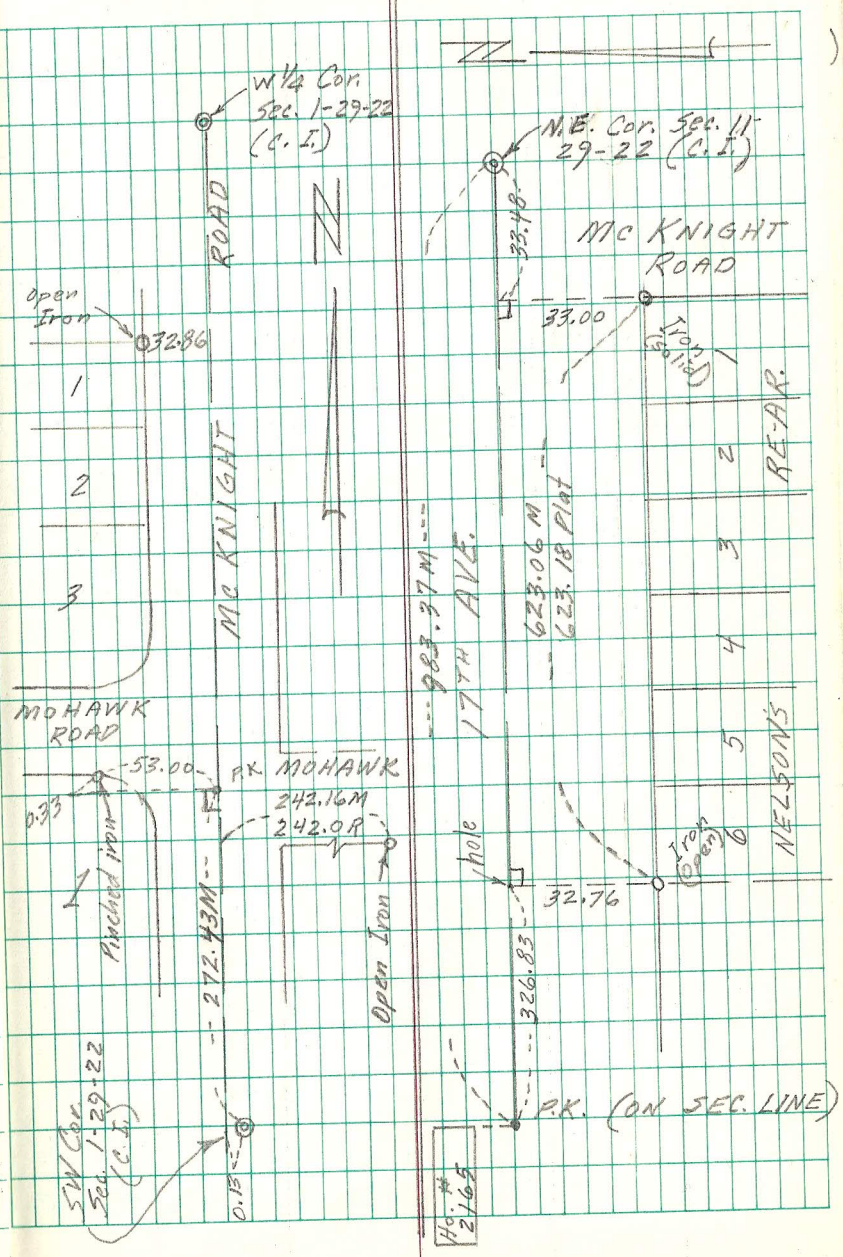
The plats of "Saratoga Hills" & "Gudim's Highland Hills" were made in 1955. No monu. shown on final plats. Irons checked prove position of existing C.I. monu. at 17th Ave. & McKnight. N.E. Cor. Sec. 11-29-22 appears good N. & S.. See page 6 & 7 about E. & W. direction.