


TOWN OF BALD EAGLE
 (Irons located in Blocks 10, 11 & 12)
 [Some irons]

o = iron found

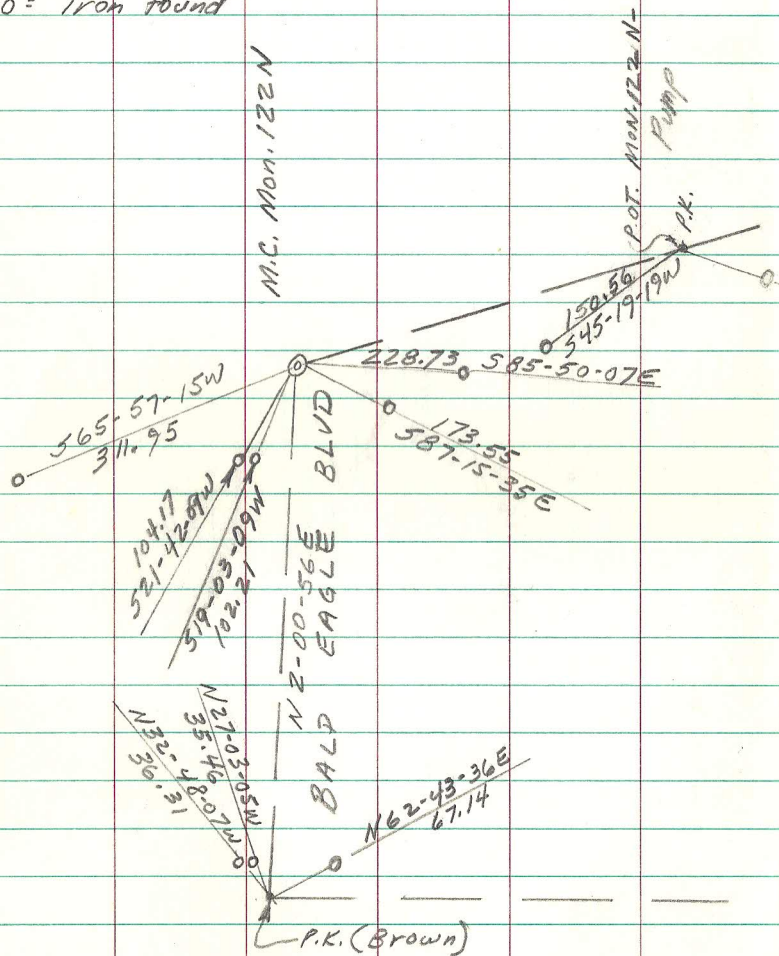

R.M. Feb. '84
 L.P.D.
 D.S

