
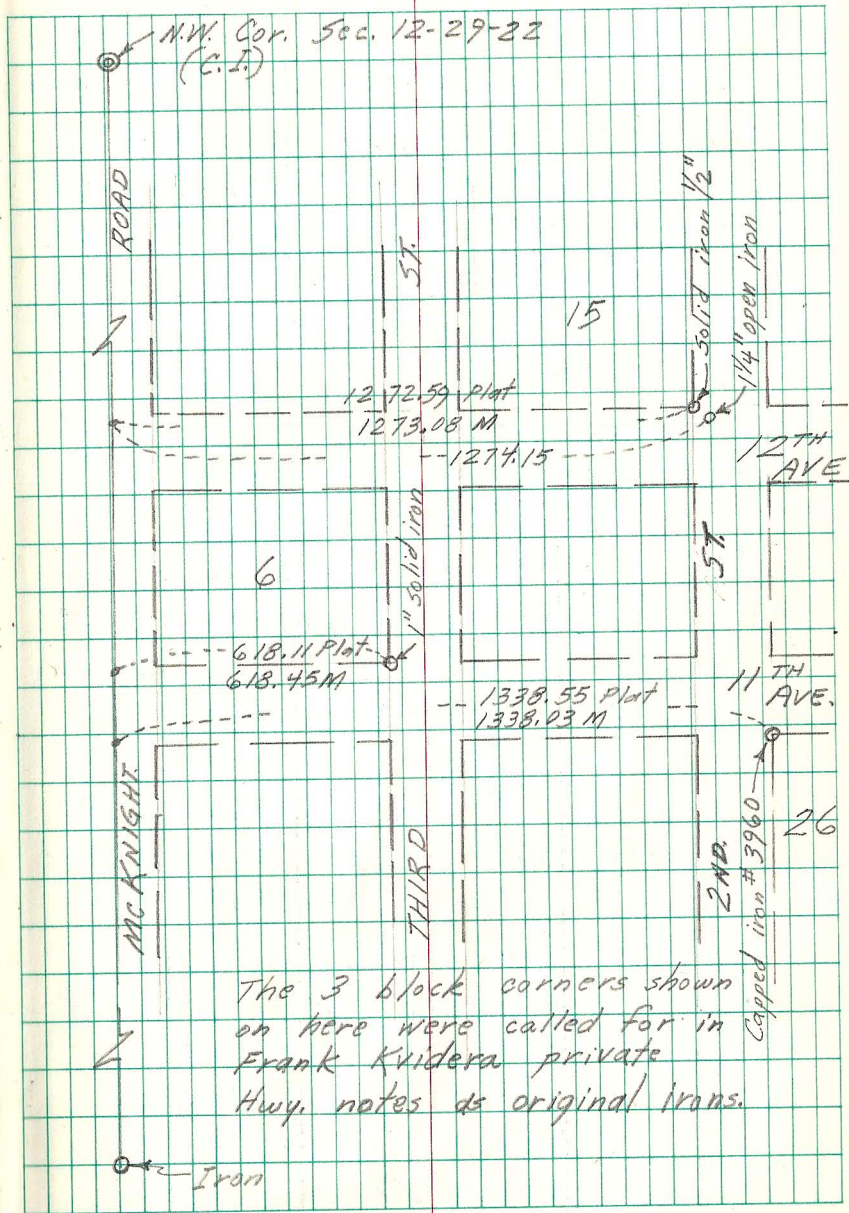


(Continued)

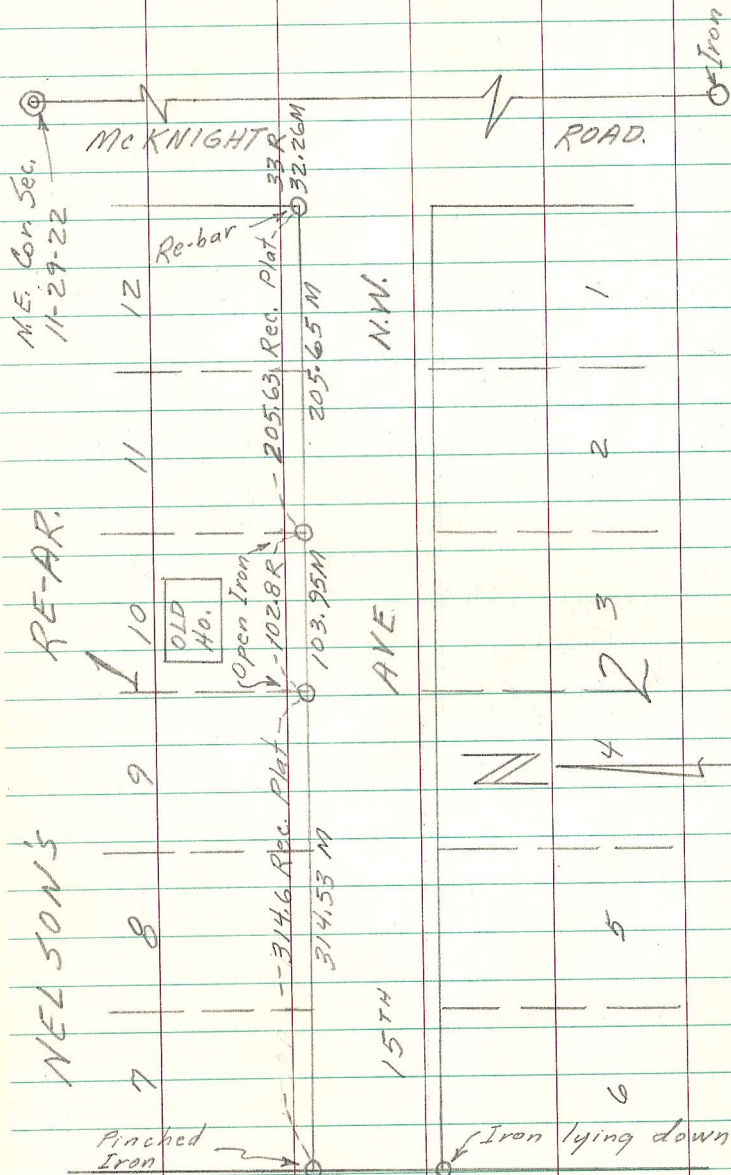

The 3 block corners shown on here were called for in Frank Kvidera private Hwy. notes as original irons.