Placed P.K. as per John Turpins notes, July 1973 & May 1978

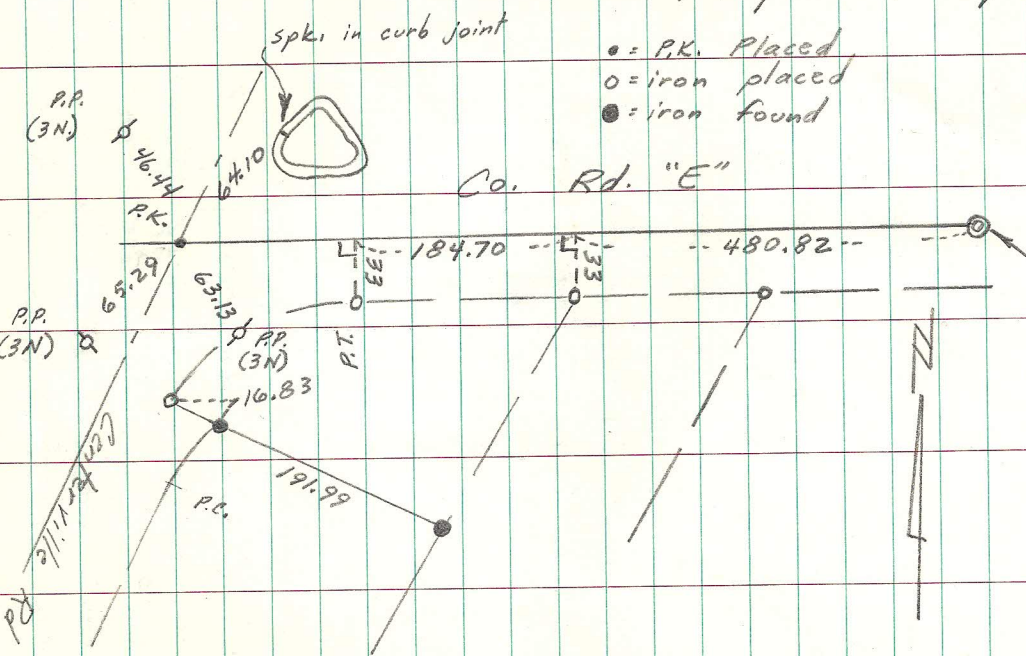

Replacing Tens Sec. 32-30-22 (Co. Rd. "E")