


Range 22  
33

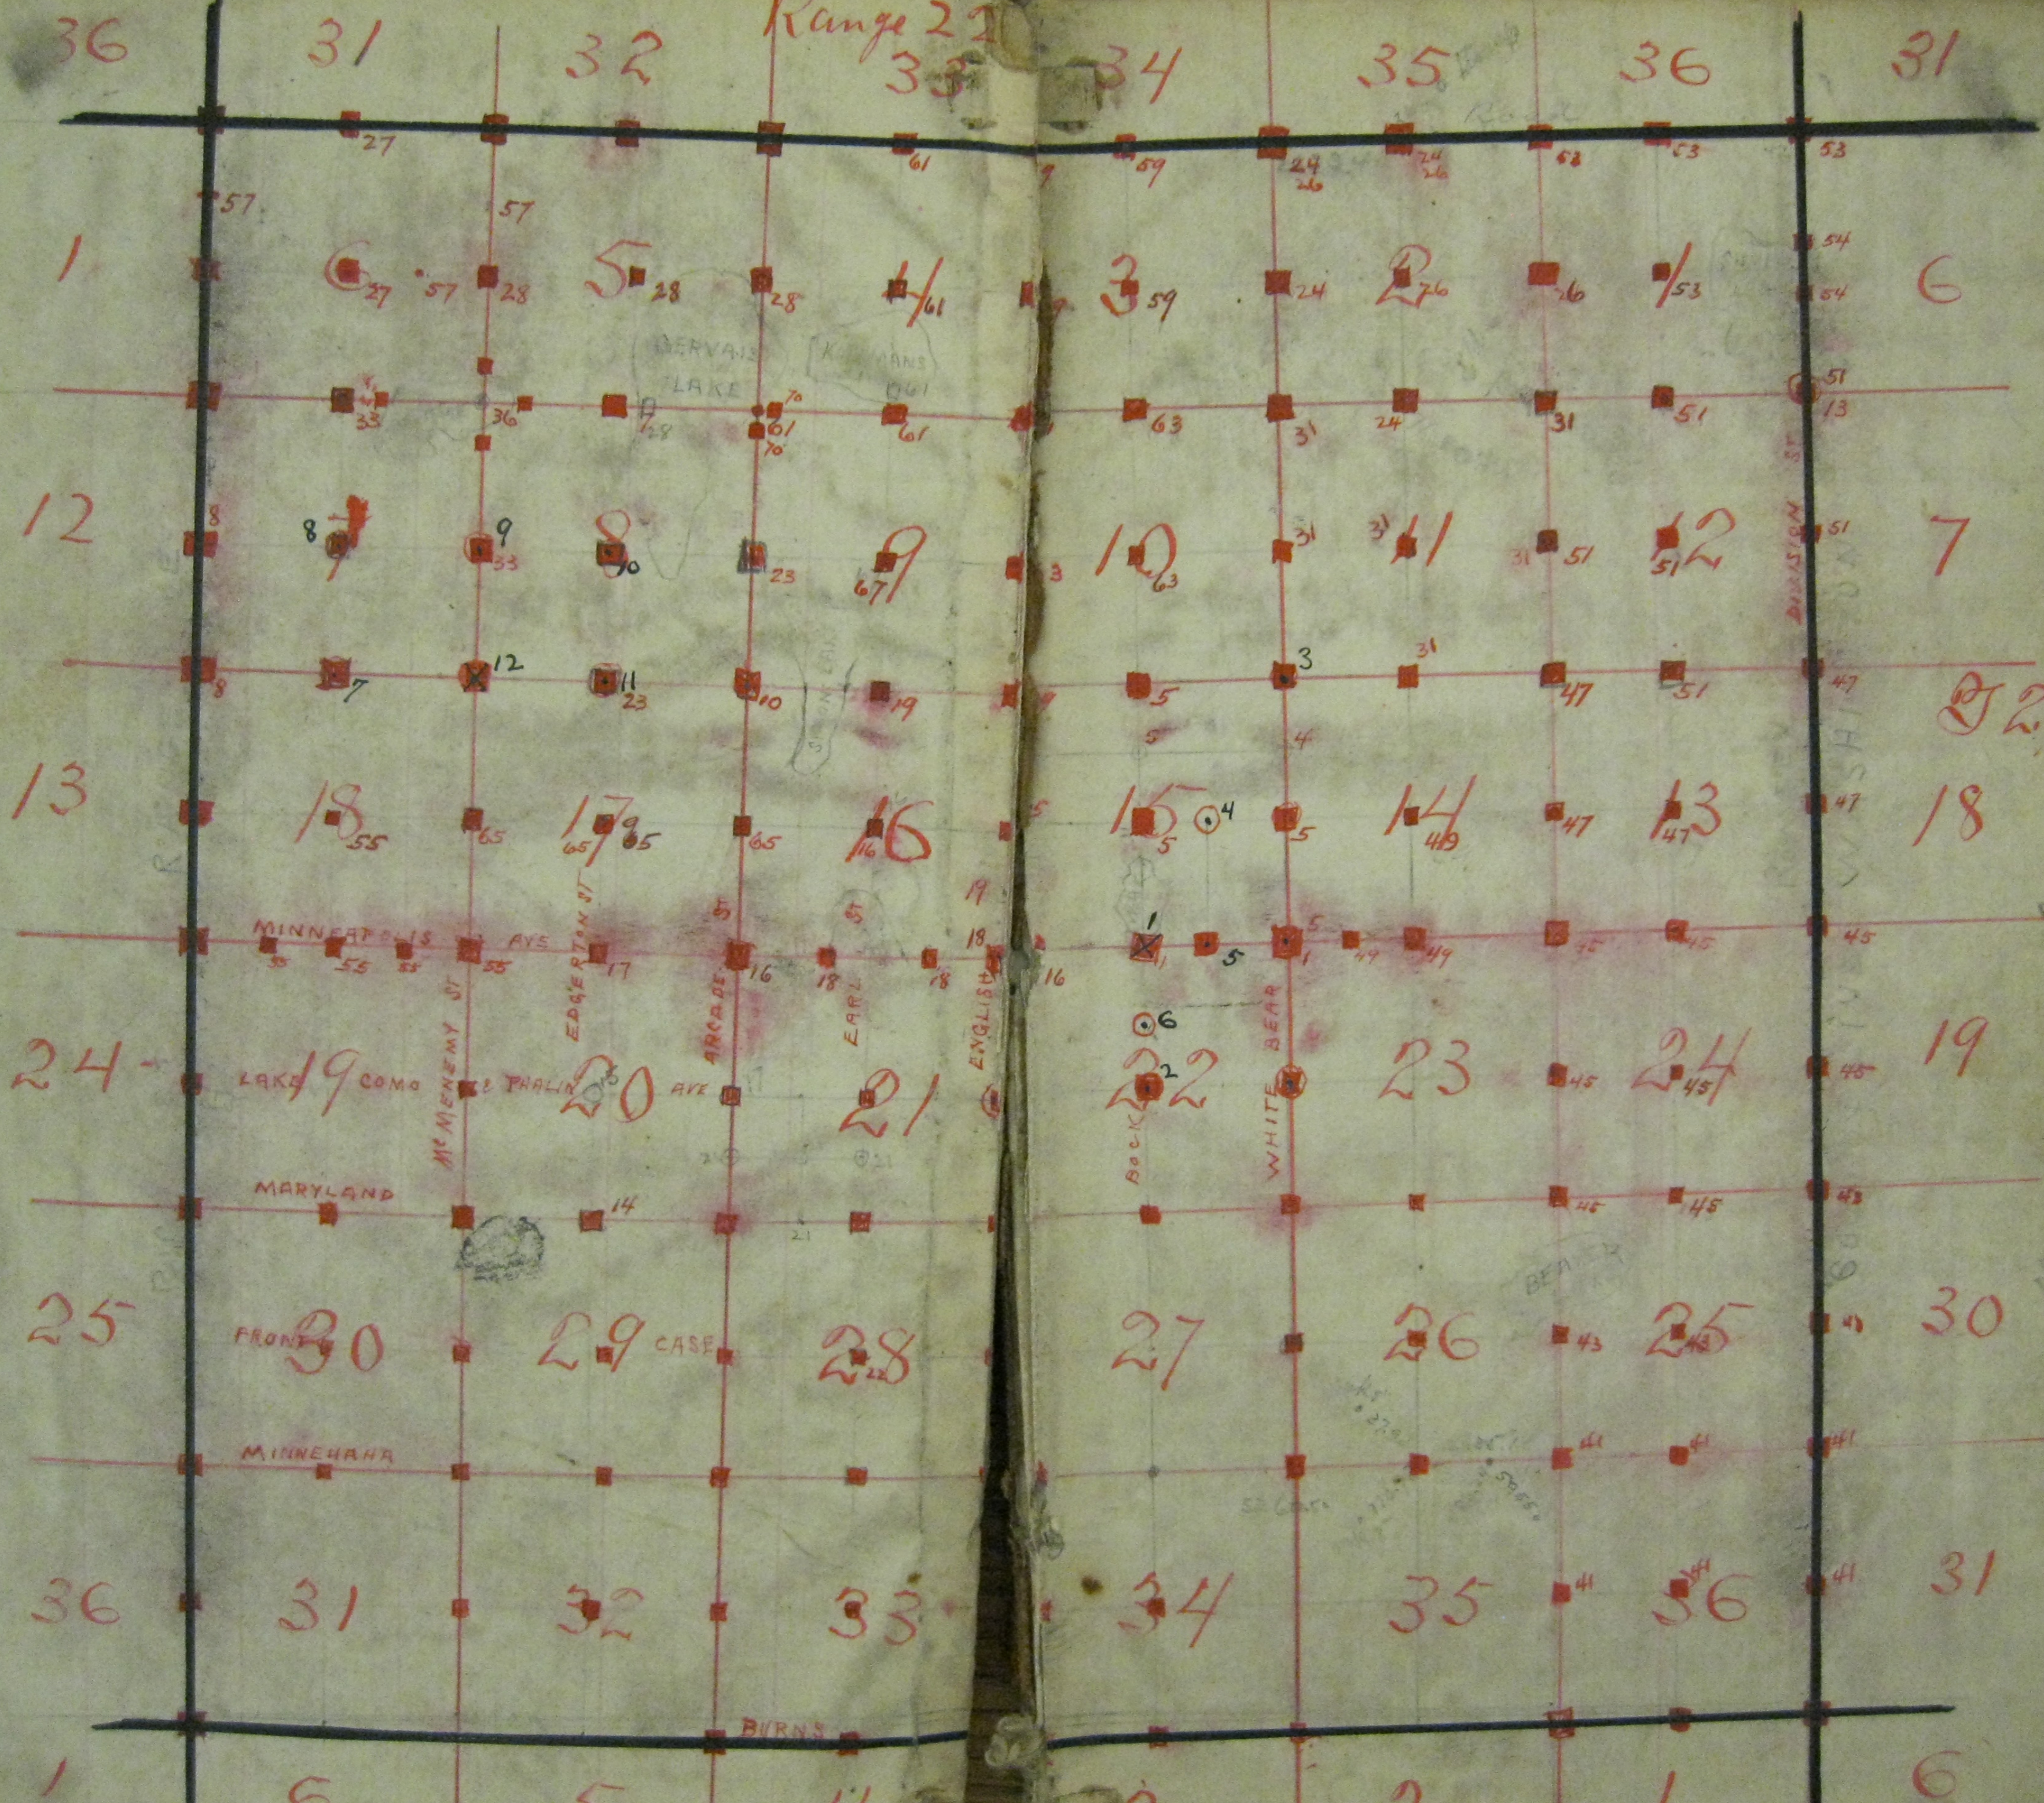

29

Washington Co

DIVISION ST

WHITE BEAR

Back

BEAVER

BURNS

MINNEAPOLIS AVE

LAKE COMO

MARYLAND

FRONT

MINNEHAHA

DERVANS LAKE

KEWMANS LAKE

MC MENEMY ST

EDGERTON ST

ARCADE

EARL

ENGLISH

CASE