


Guards to 1/4 cor Between Sec 15 + 22 T29R22

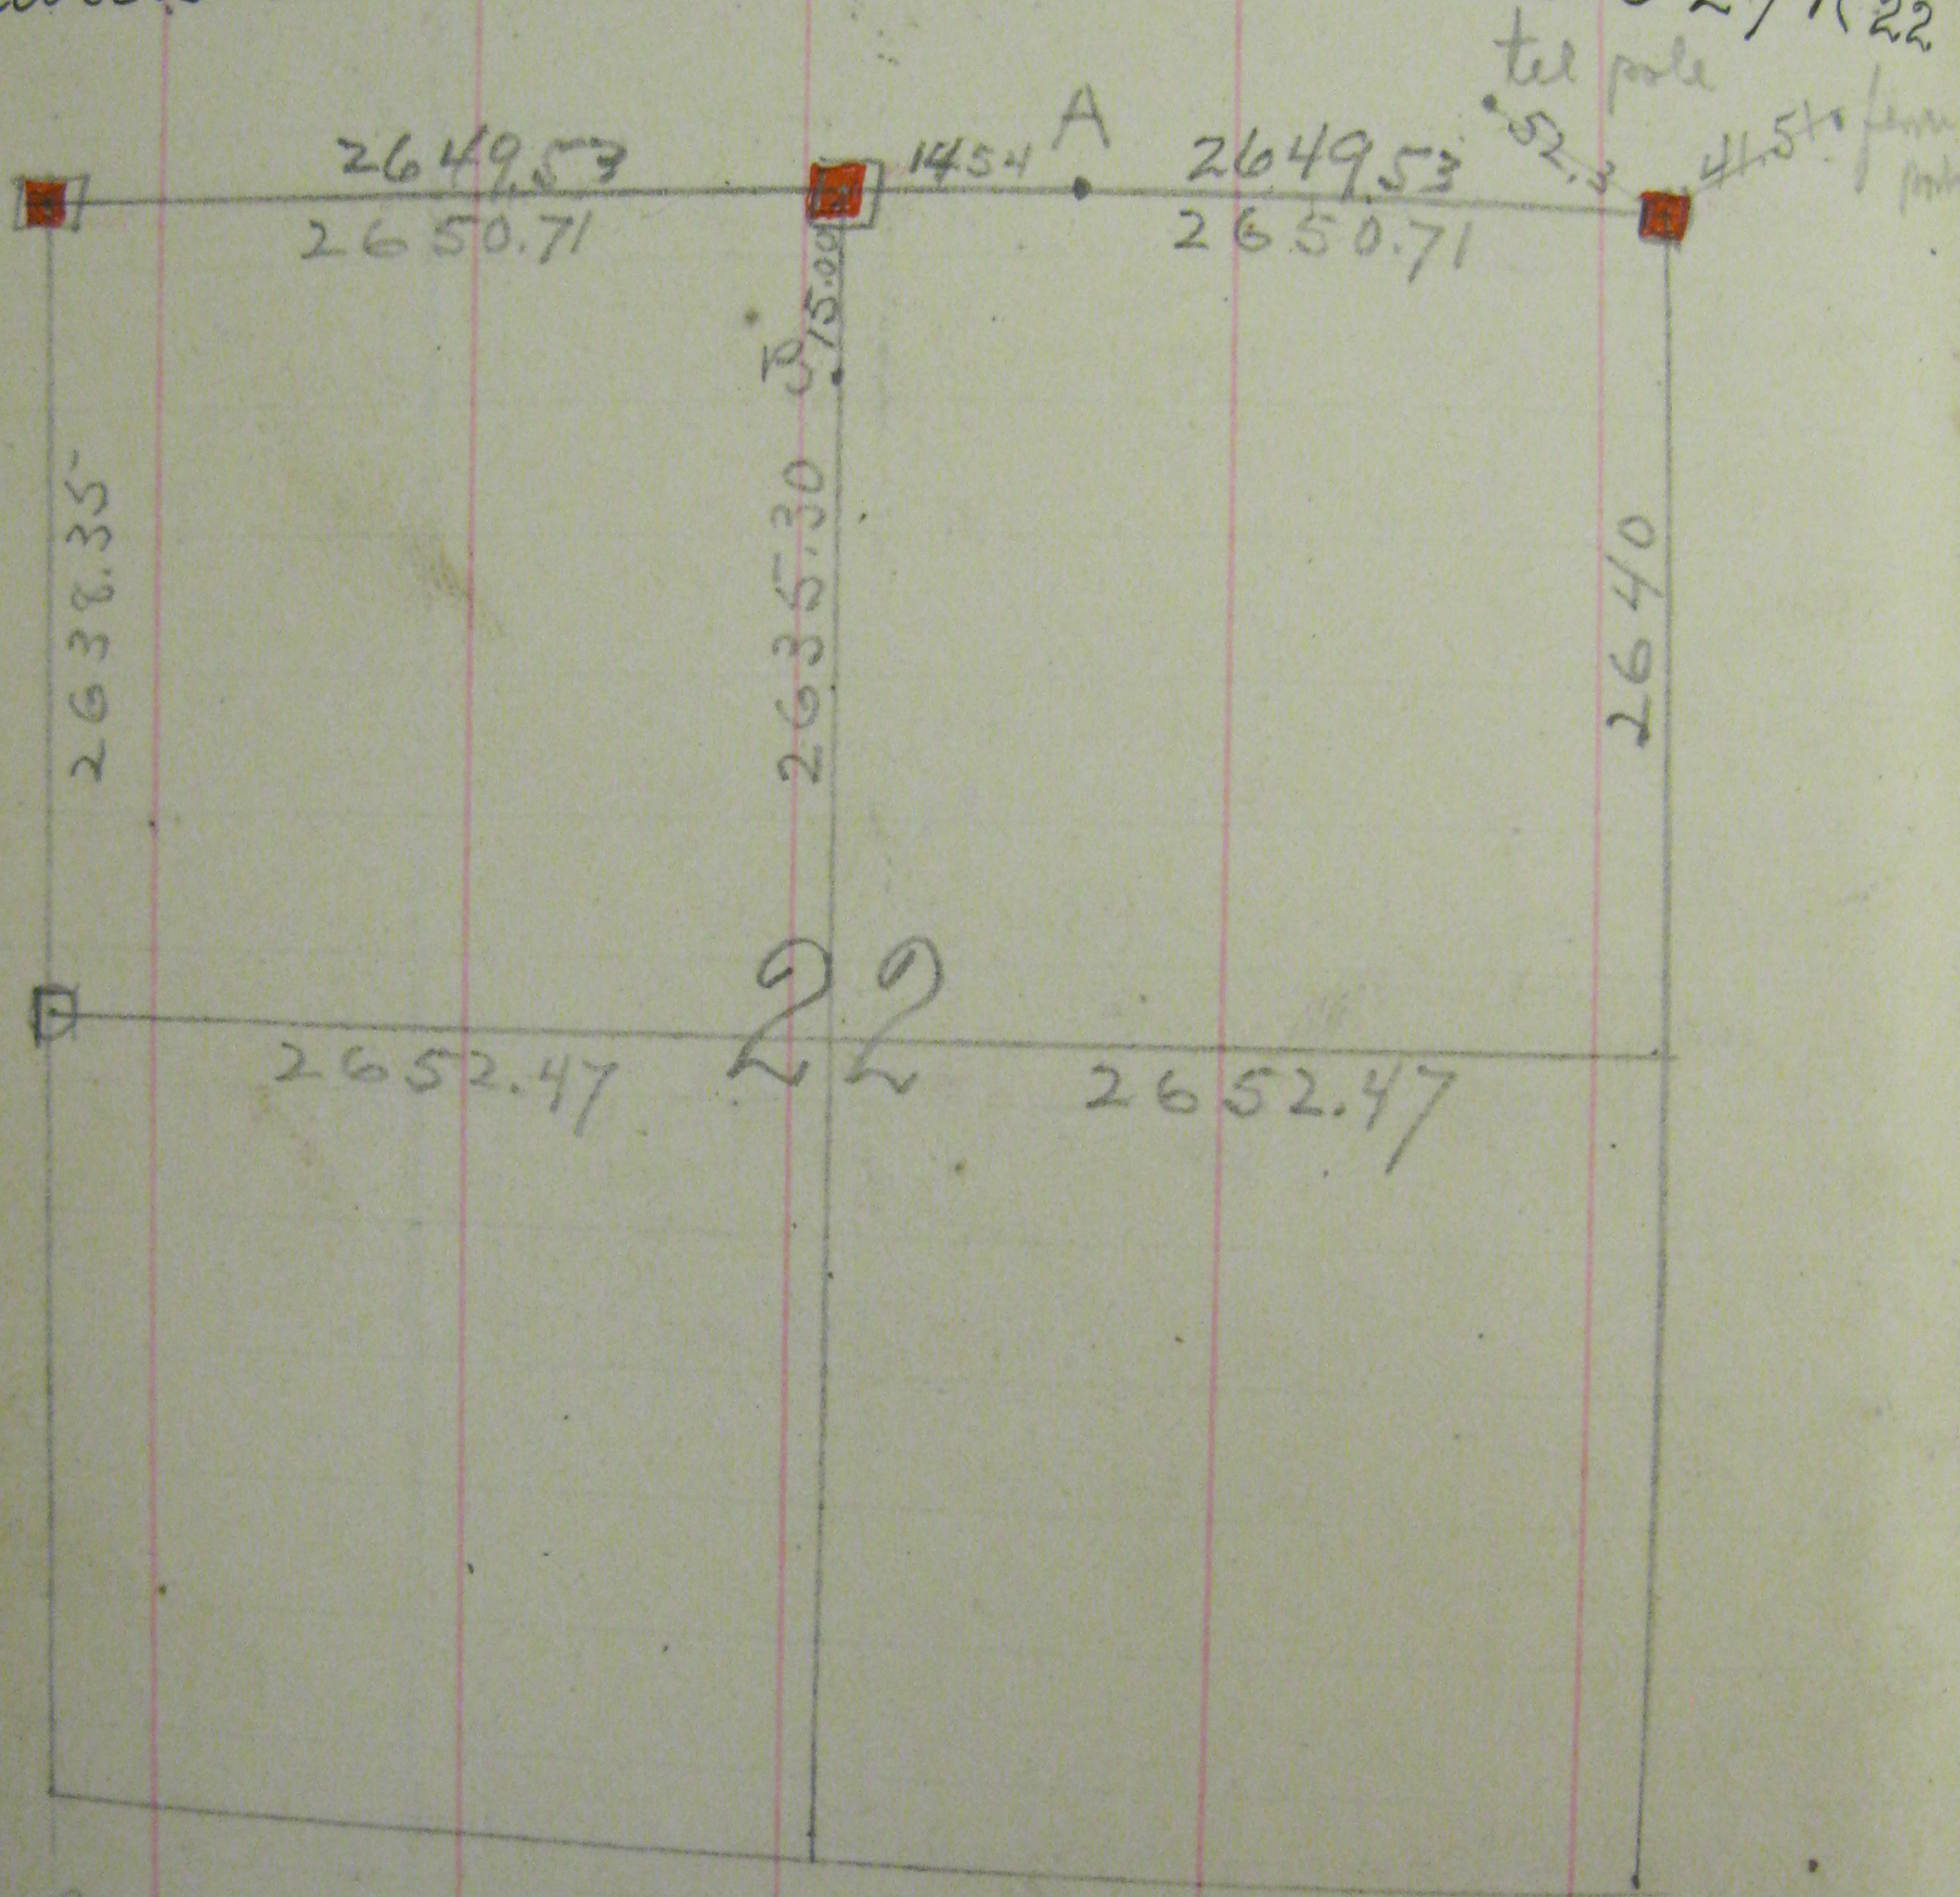

A = Boulder 14.54
 B = " 15.00