


# Centre of Sec 8 T29 R22

A = 2 tacks in double Yellow

B = 2 " " " Oak 70.29

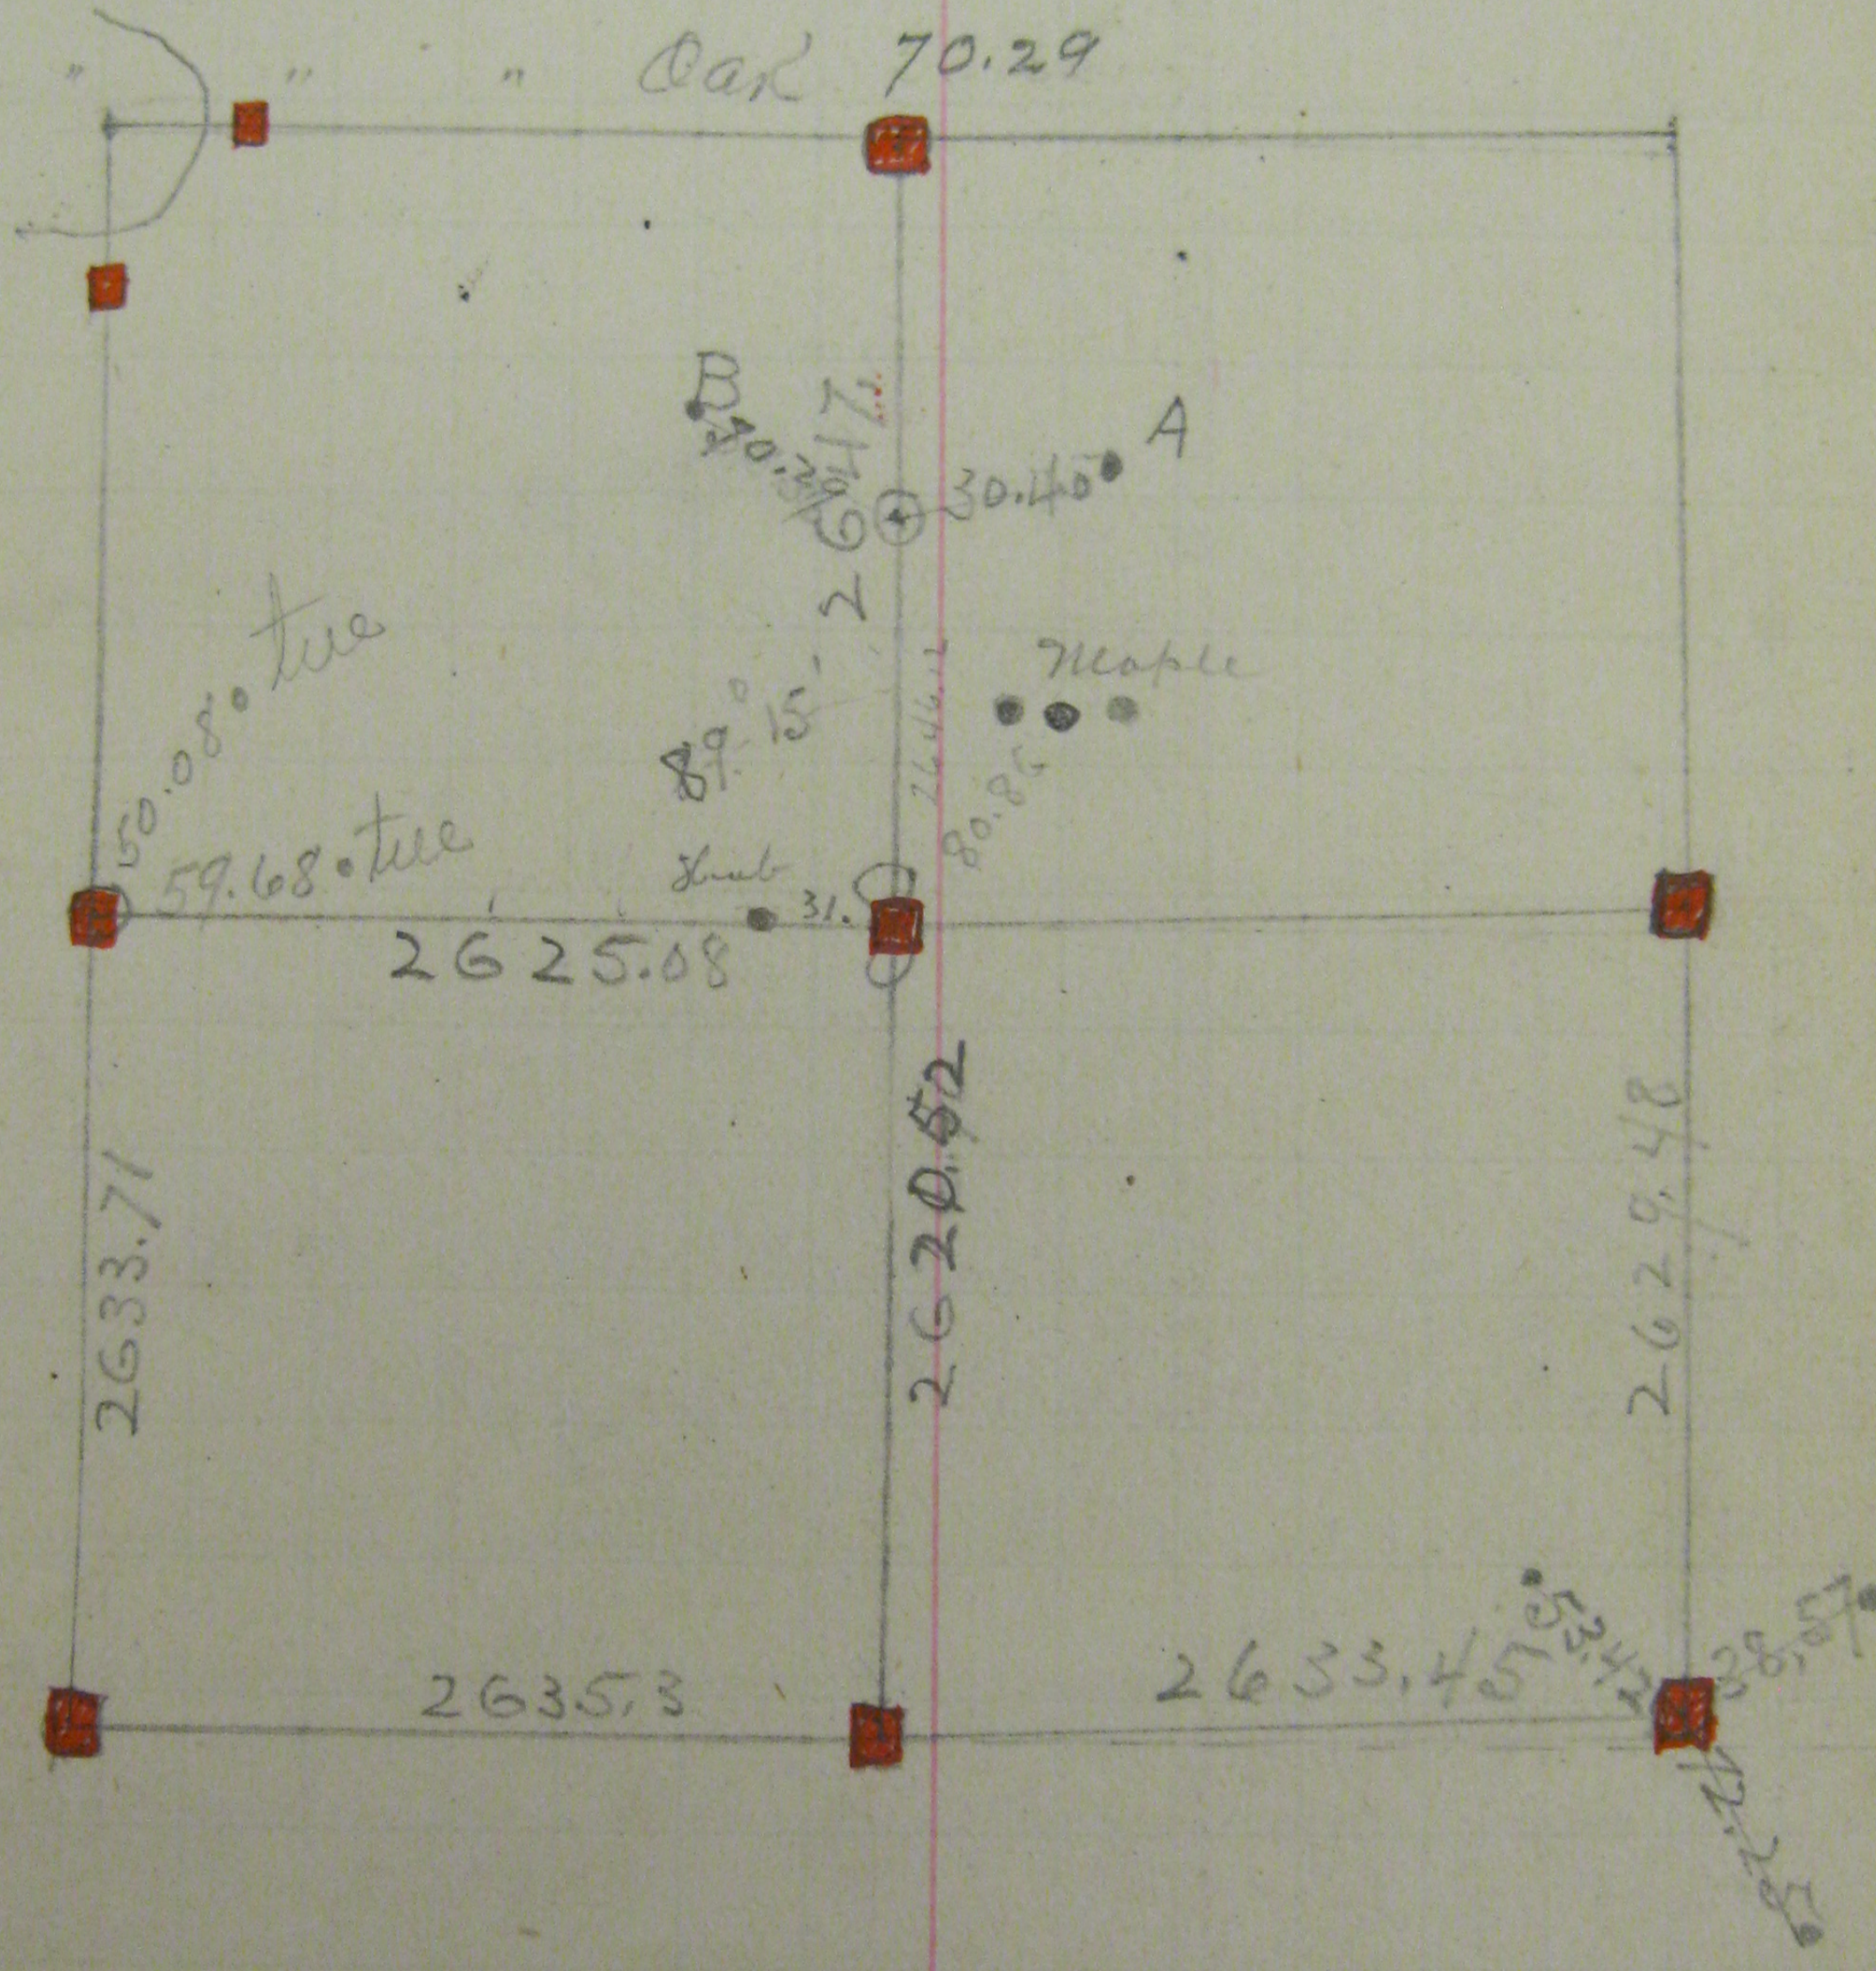

Variation 10° 15'