


1/4 sec cor  
Between Sections 20 & 29  
T29N R22W

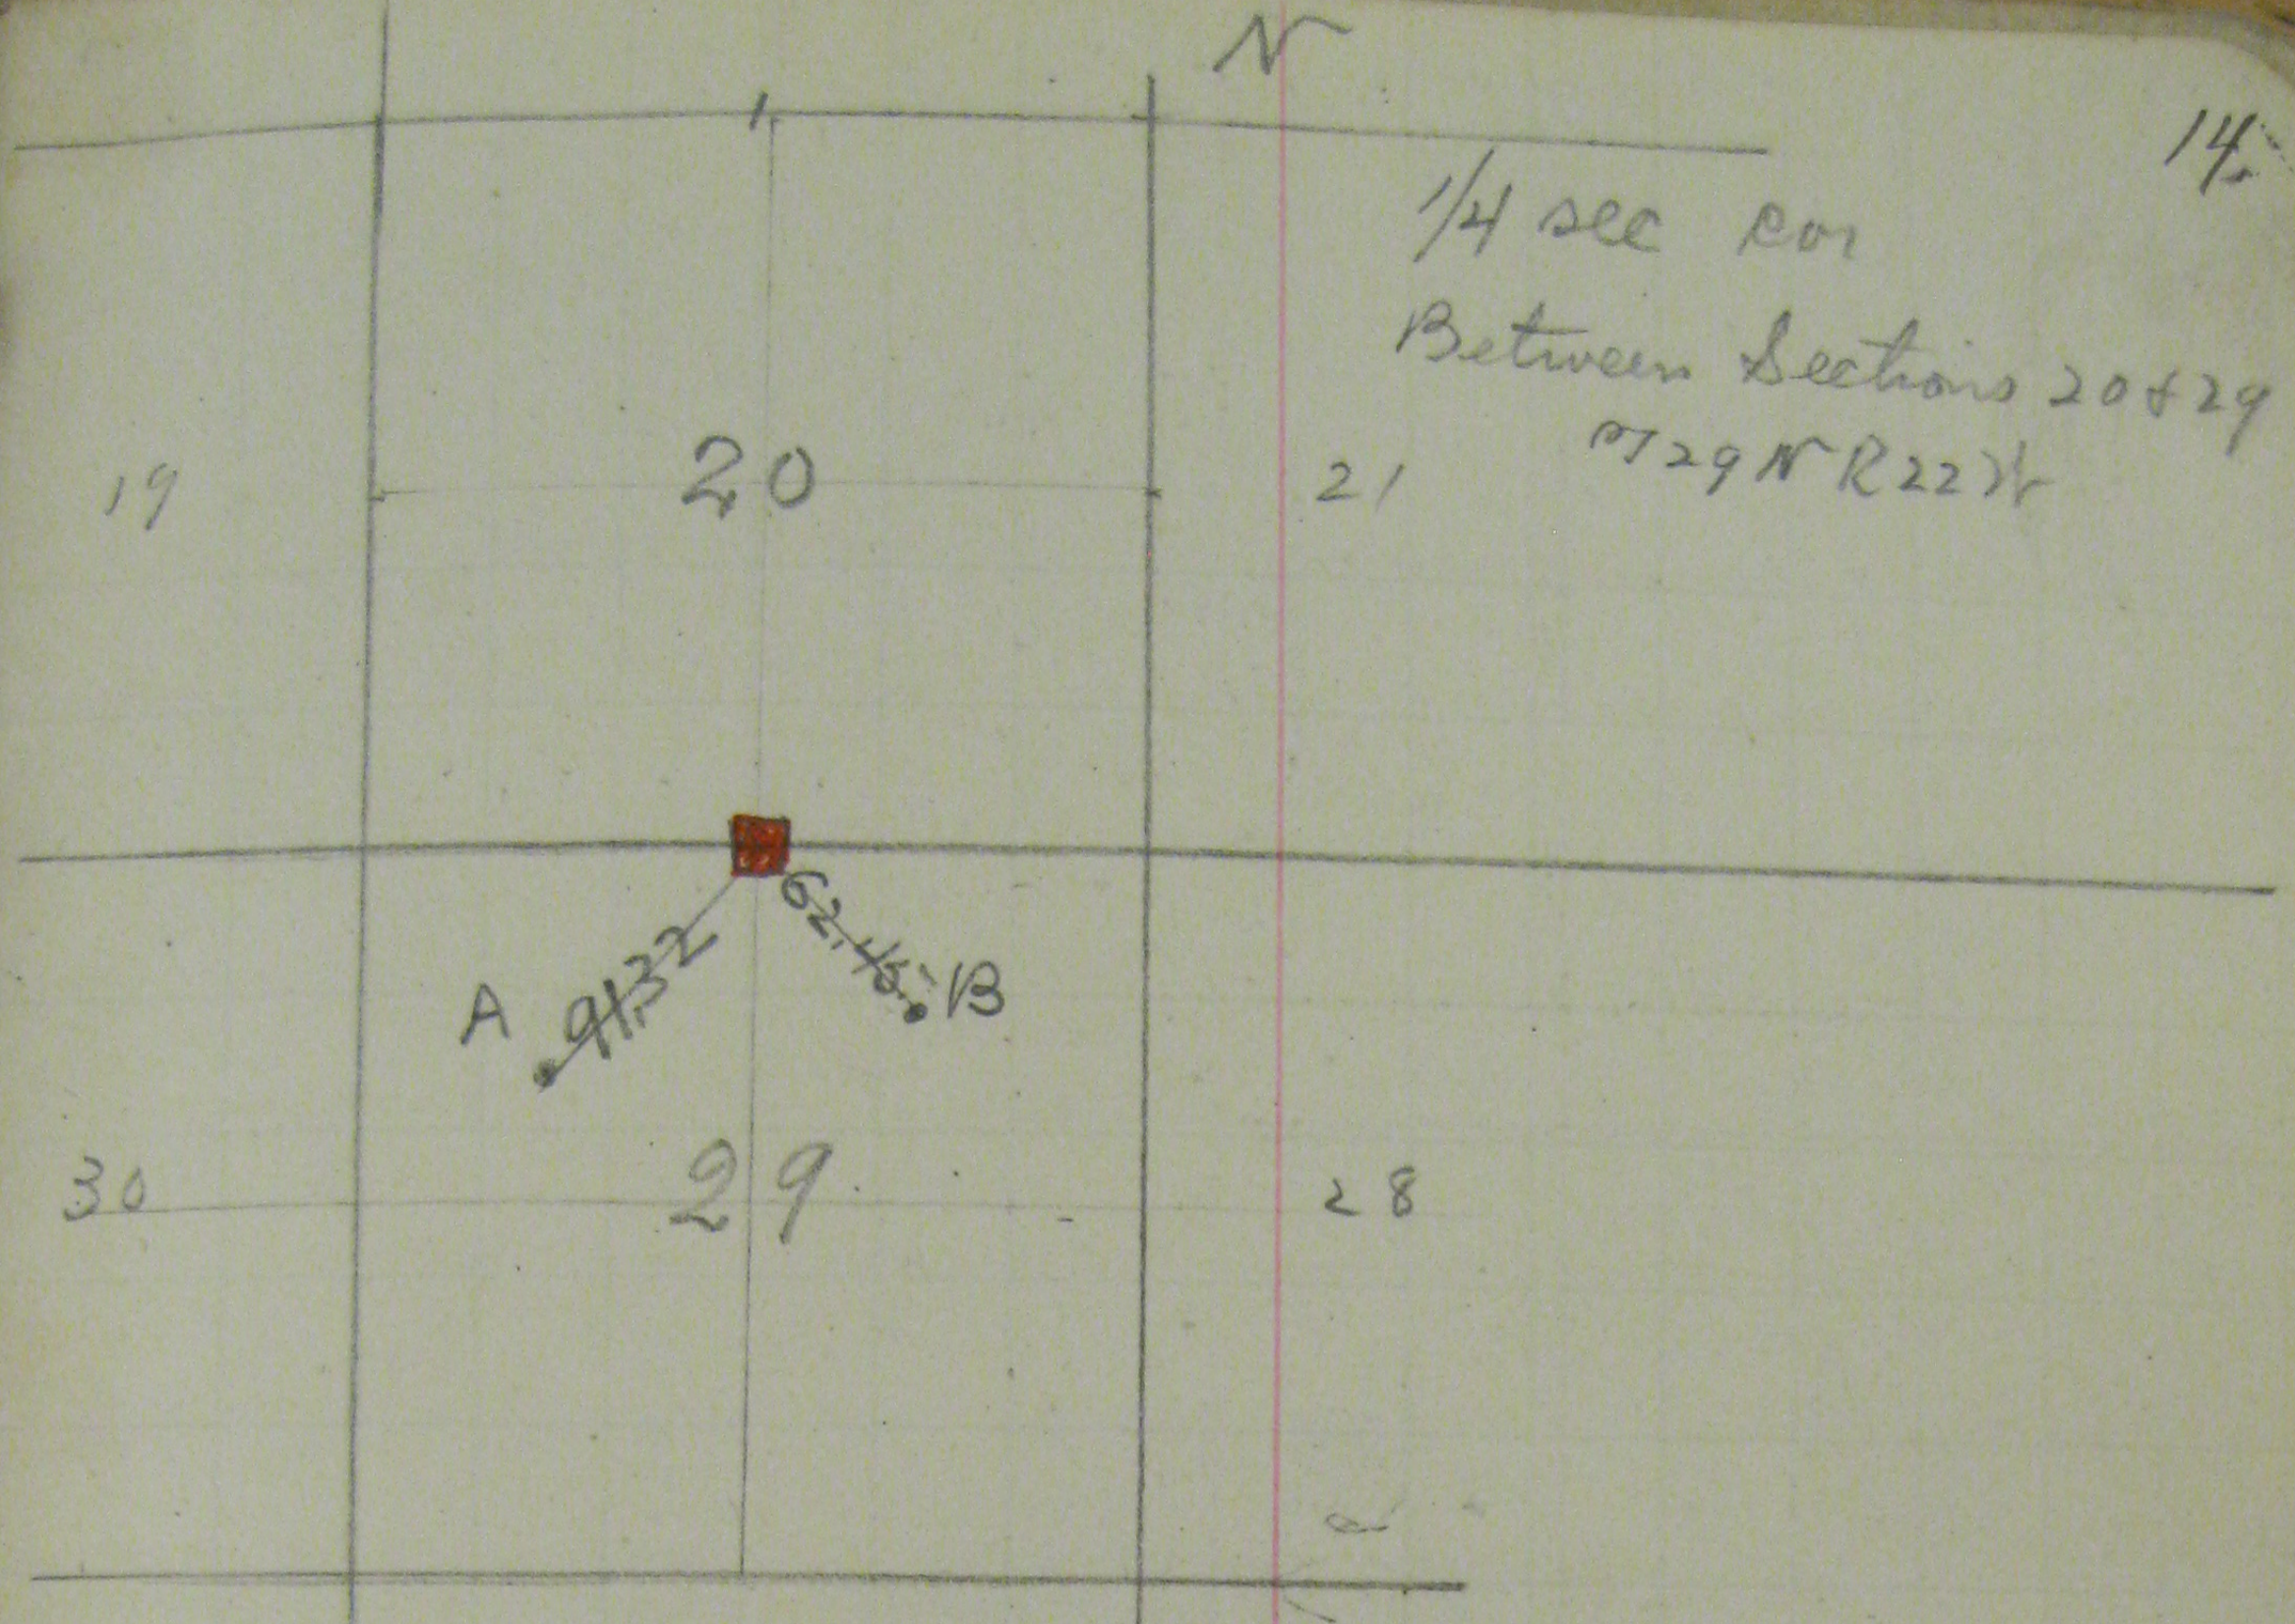

A = 3 Nails in Bek @ (12") 91.32

B = 3 " " Bek @ (10") 62.45

this monument is the centre of Maryland  
and Edgerton Streets