


15


Centre of Arcade and Maryland

SEC CORNER BETWEEN 20, 21
28 AND 29 T29 R22W

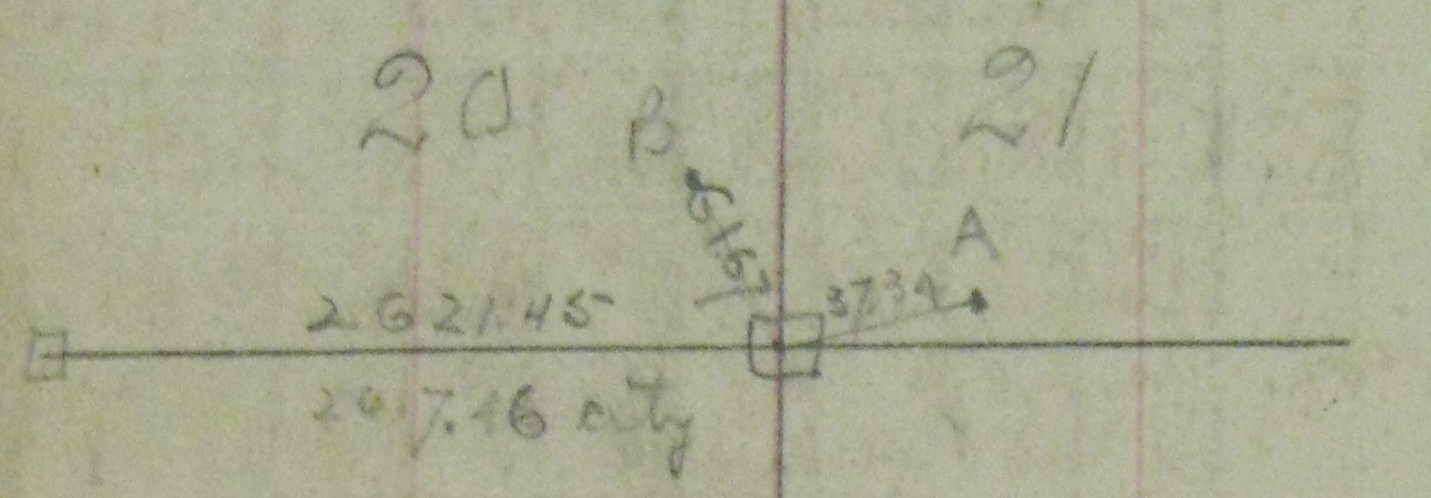

Chained Sept.
21st 1886

A = 3 Nails in Bek O 37.34
 B = 3 " " " " 61.67

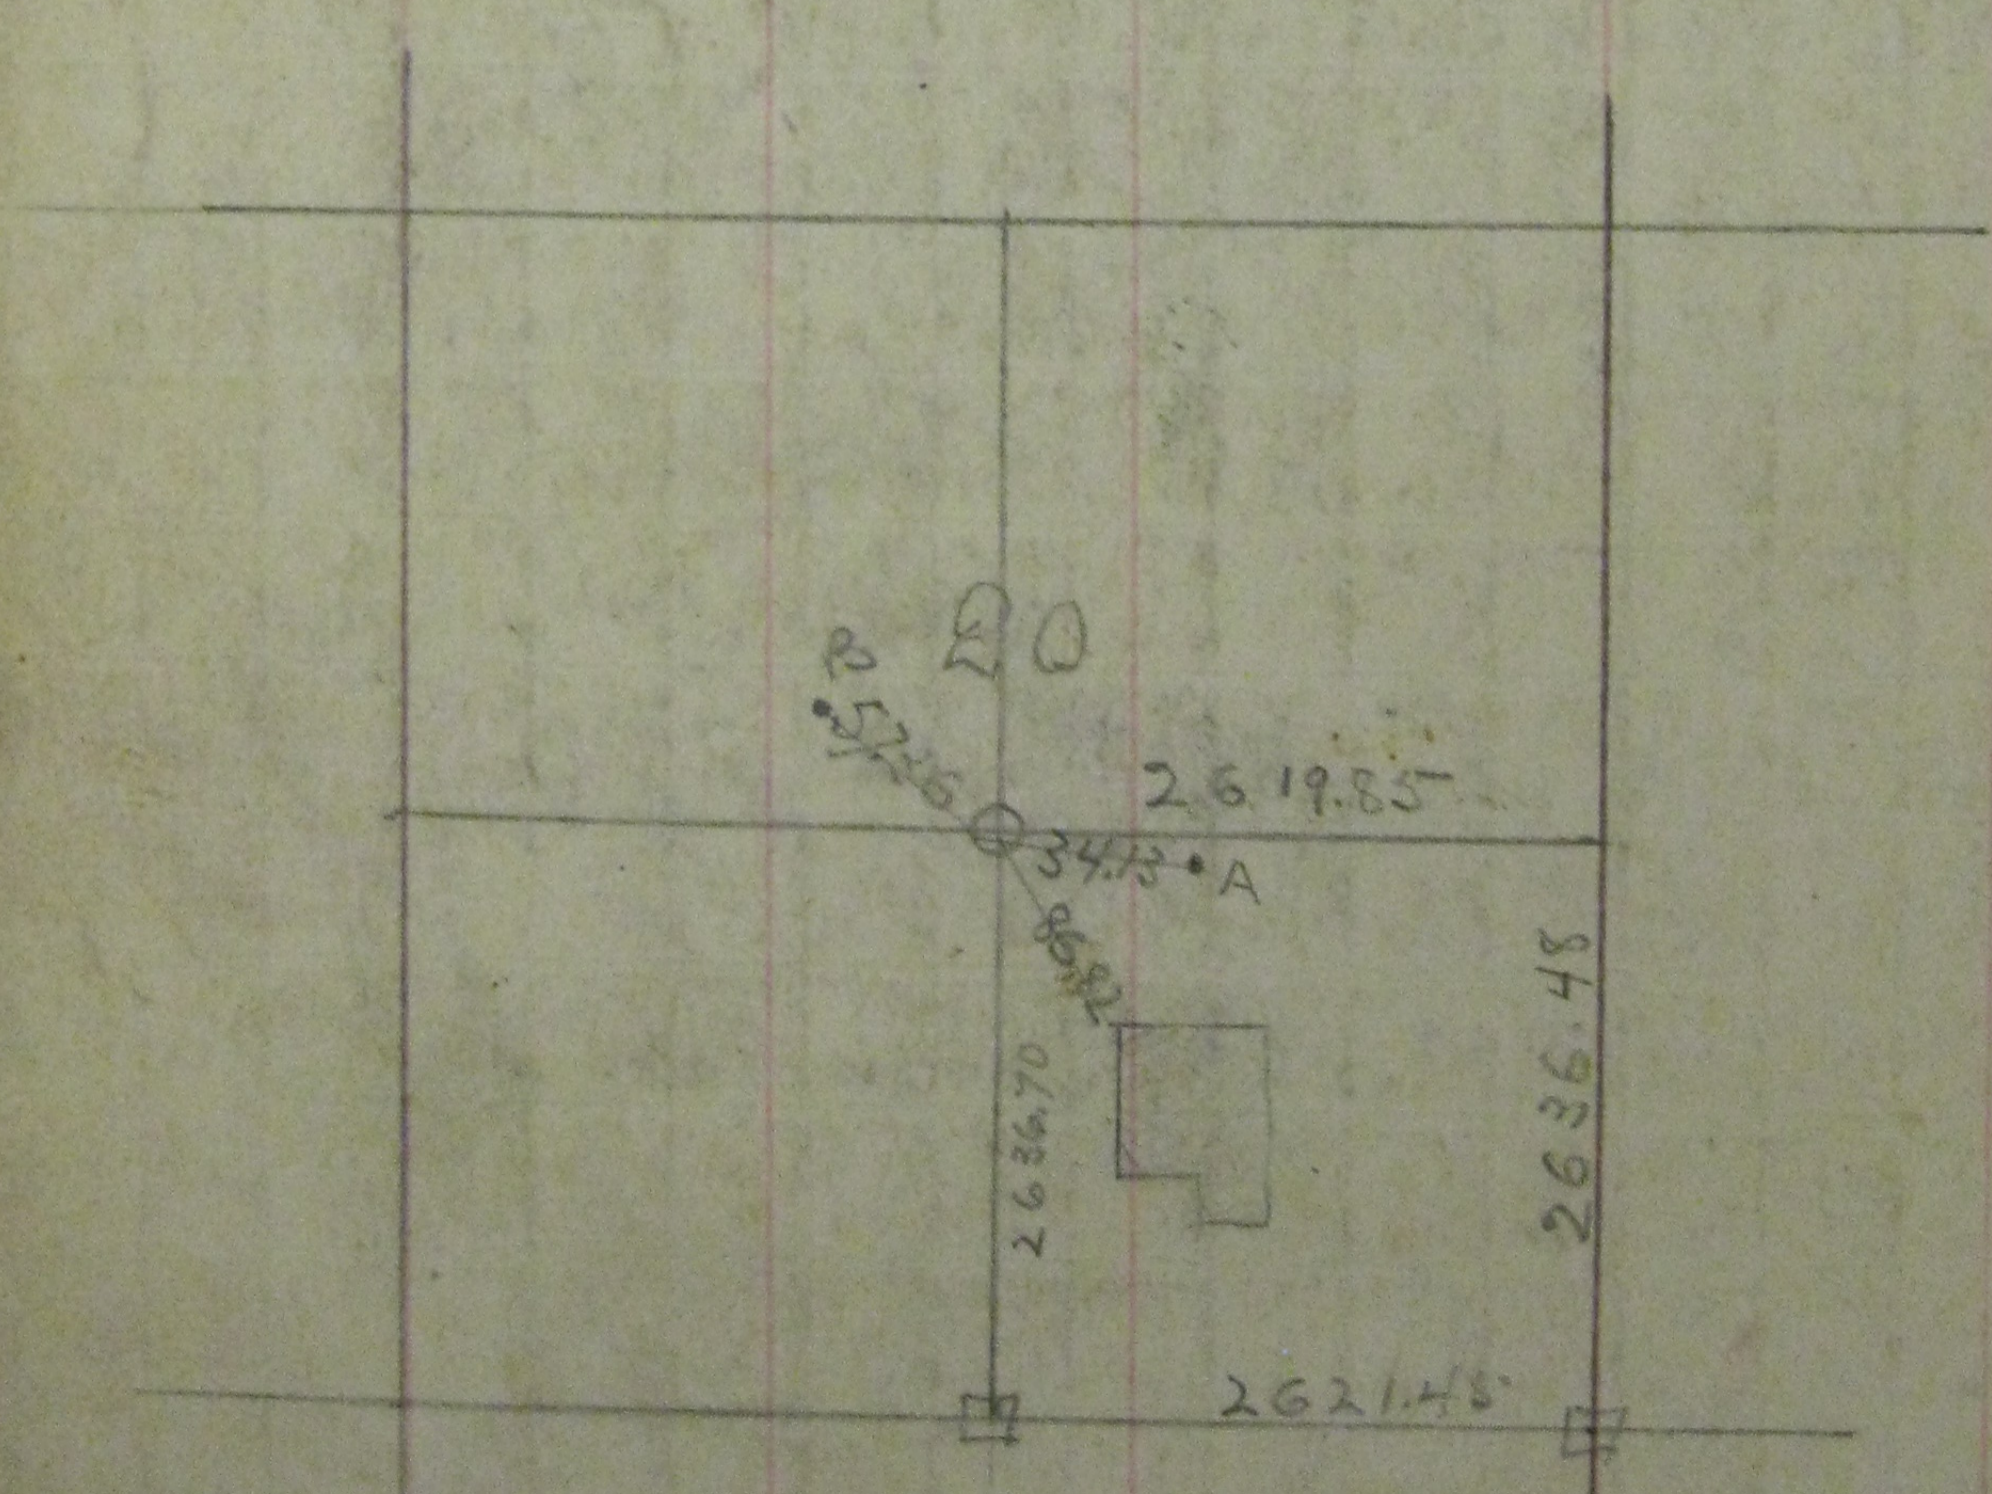

A = 3 Nails in maple (30") 34.13
 B = 3 Nails in poplar (12) 57.36